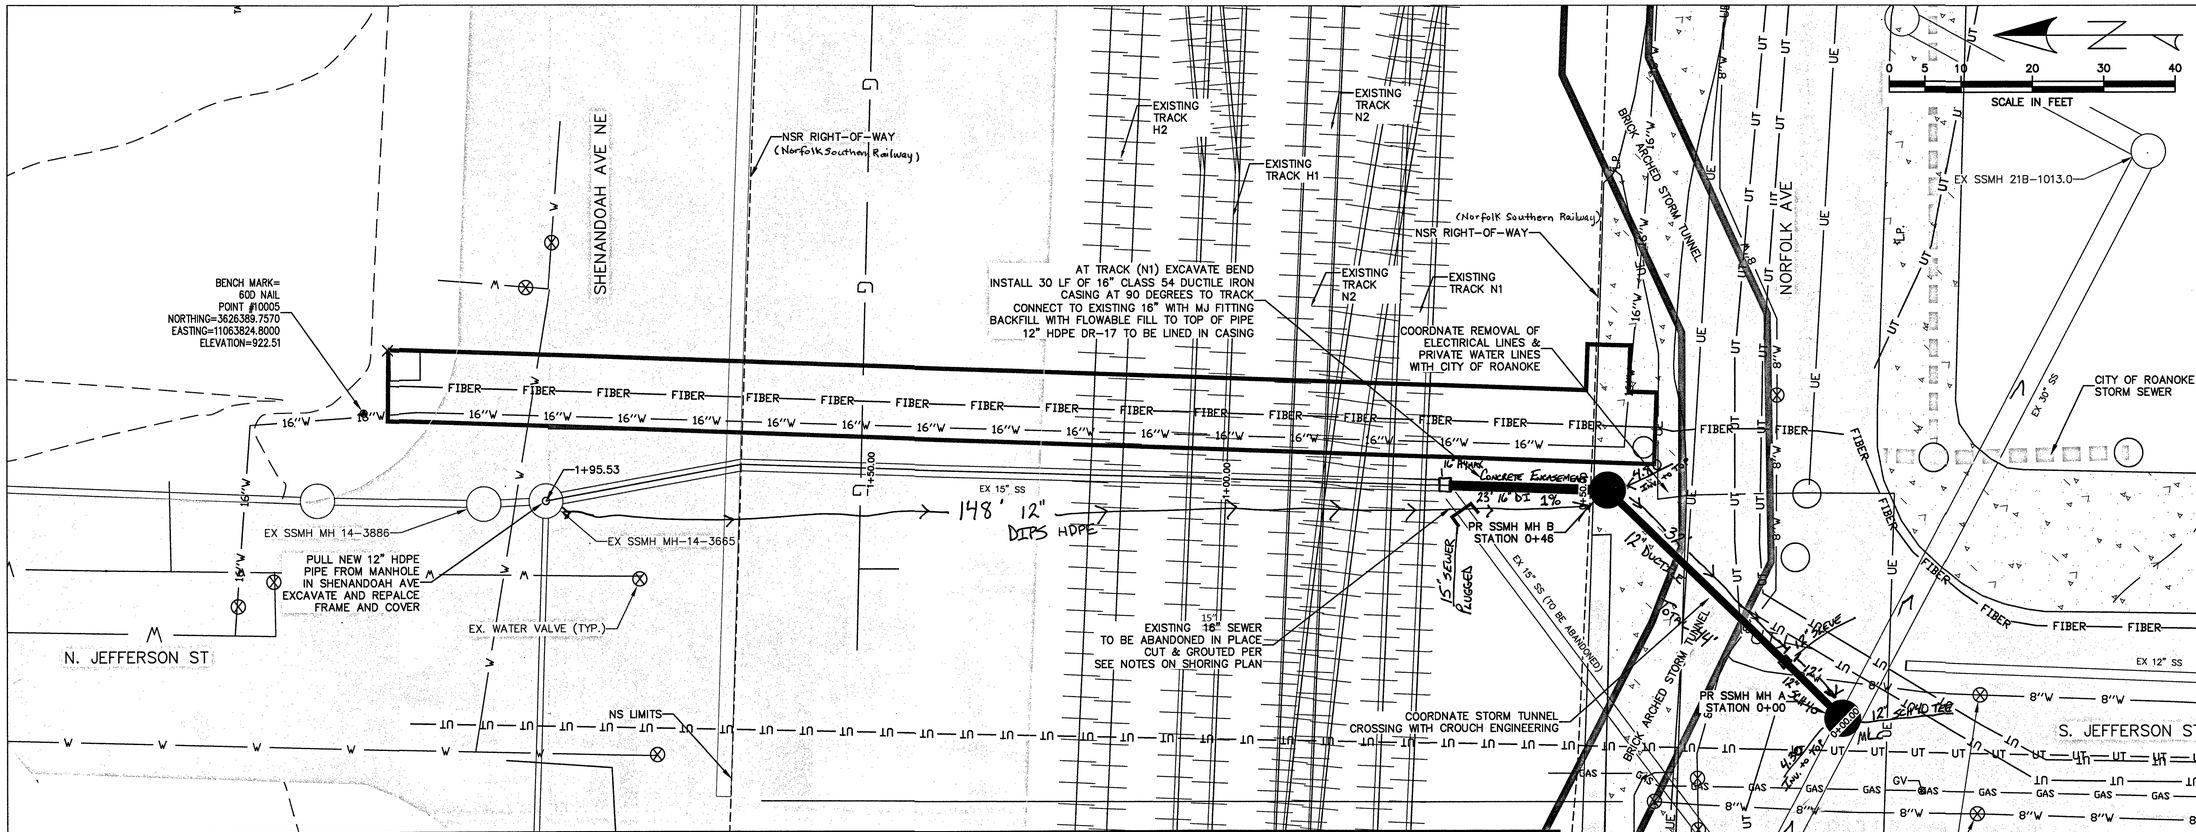

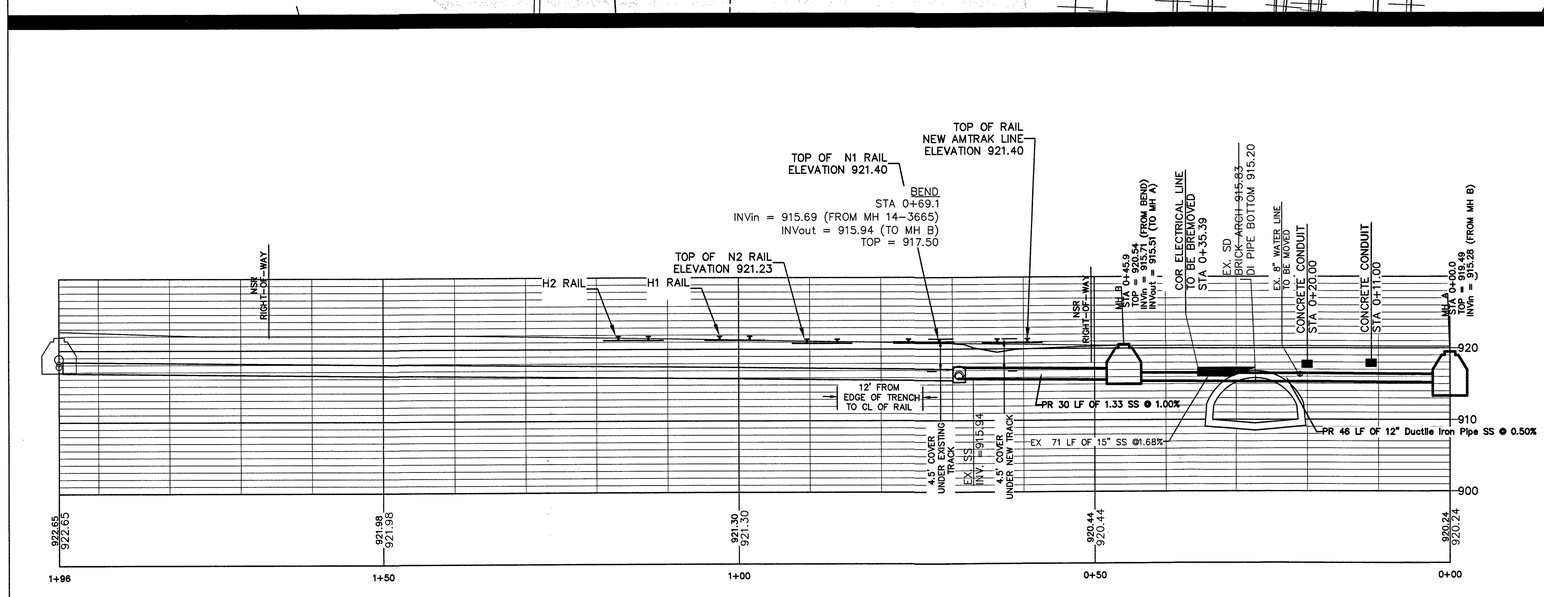

AMTRAK REALIGNMENT
SCALE
VERTICAL: 1"= 10'
HORIZONTAL: 1" = 10'

WESTERN VIRGINIA WATER AUTHORITY
ENGINEERING SERVICES
601 S JEFFERSON ST, SUITE 300
ROANOKE, VA 24011
540-853-5641 or 540-853-5770

WORK COMPLETED ON 3-13-17
CIP2 SEWER
TAFT BEASLEY

NS JEFFERSON SEWER
(NS=Norfolk Southern)

PLAN & PROFILE

Rev	Description	Date	By
1	cut sheet data added	2-13-17	
2	NSR REVISIONS	2-24-17	

Designed: AAS
Drawn: AAS
Checked: TEC
Approved:
Date: 2-8-17
Project:

1
Sheet 1 of 1

"ASBUILTS"
SEWER