


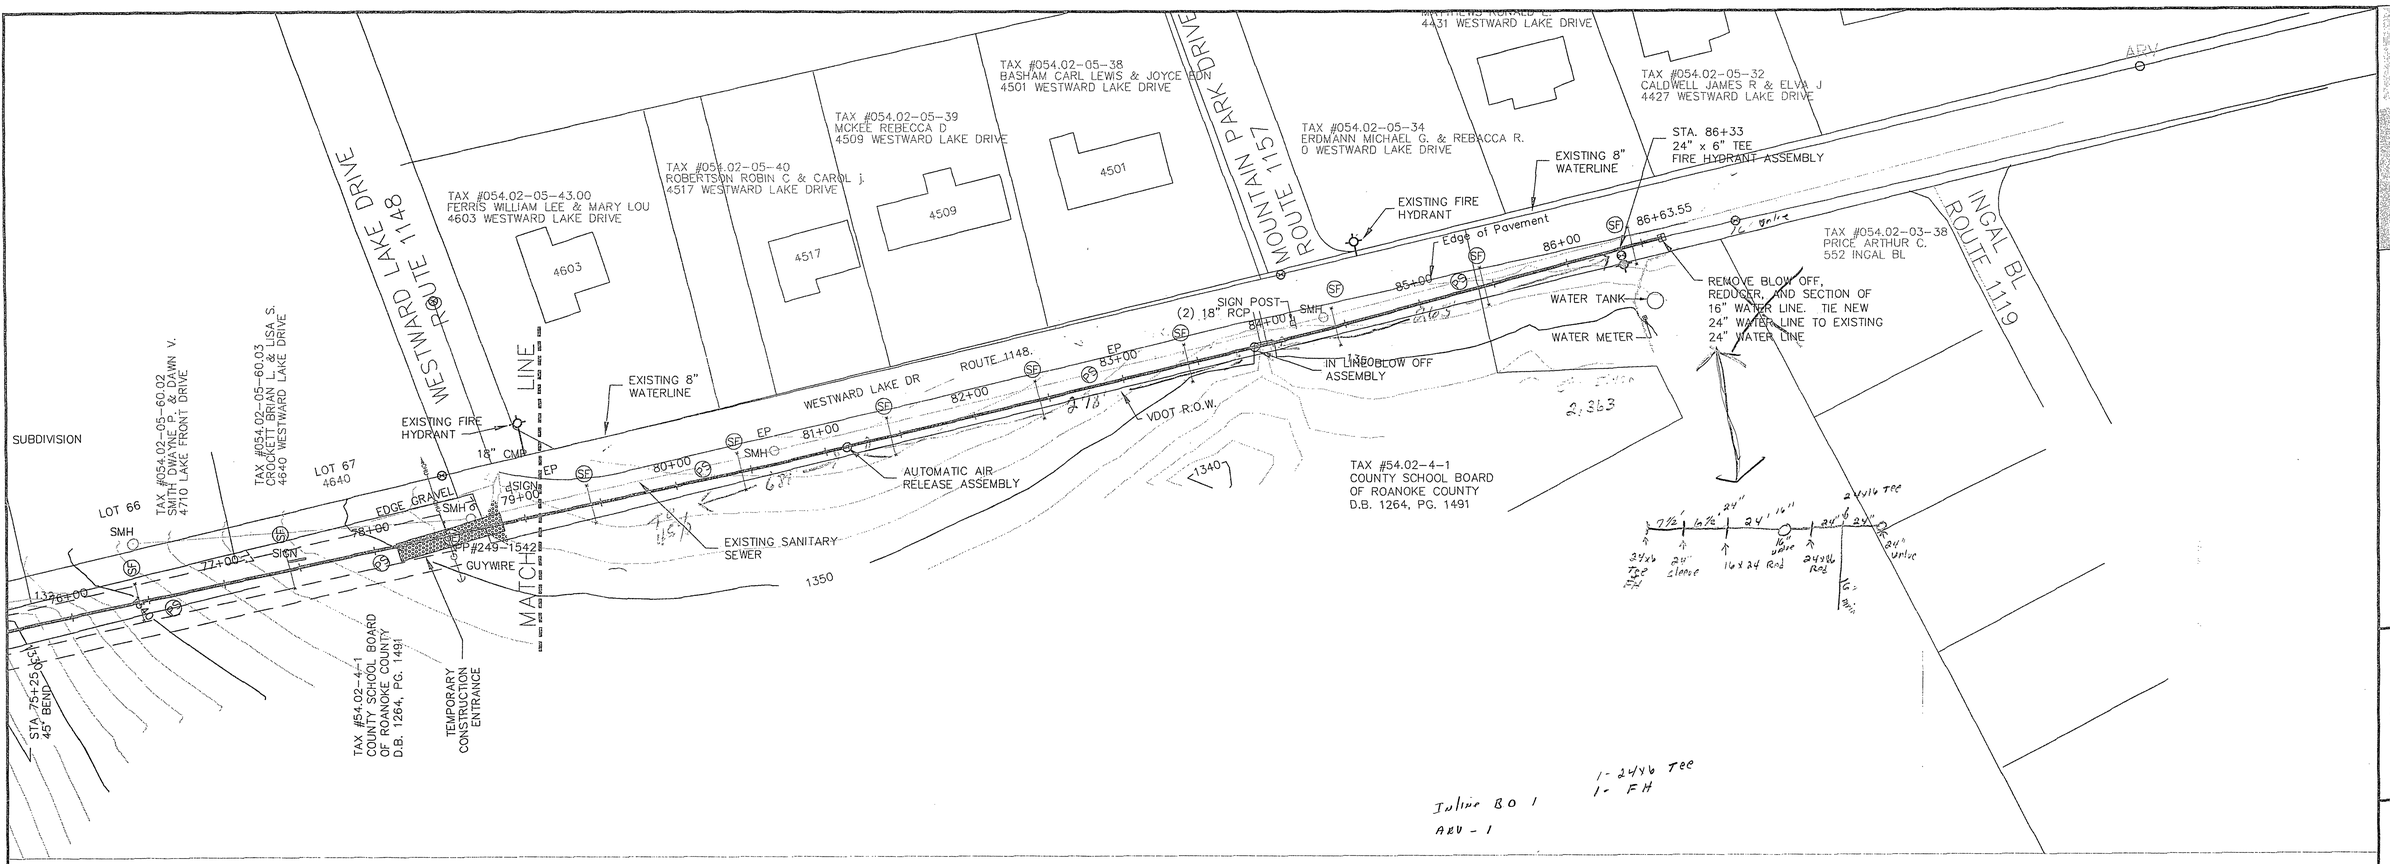


WESTERN VIRGINIA WATER AUTHORITY

**ENGINEERING SERVICES**

601 SOUTH JEFFERSON STREET
SUITE 300
ROANOKE, VIRGINIA 24011
PHONE: (540) 853-5641

COMMONWEALTH OF VIRGINIA
Roger R. Blankenship
040615
7-21-06
PROFESSIONAL ENGINEER
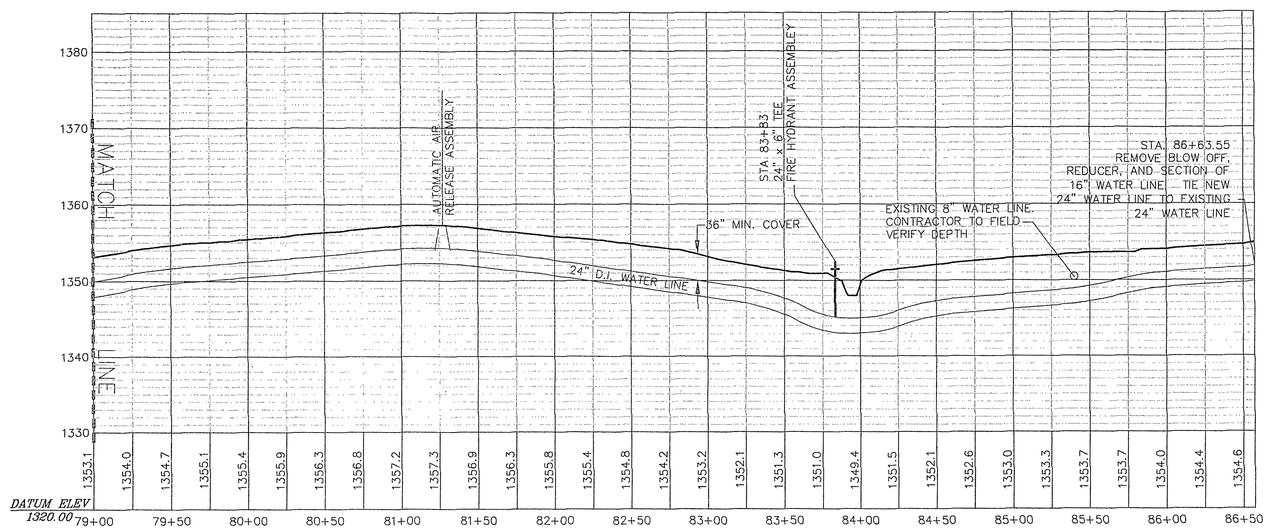
# NORHT LOOP PHASE 5
## PLAN & PROFILE

| | |
|---|---|
| Designed By: | RRB |
| Drawn By: | RRB |
| Checked By: | JGR |
| Date: | 06/02/06 |
| Scale: | HOR. 1" = 50'<br>VERT. 1" = 10' |
| Plan #: | 00-00 |
| Sheet: | 10 OF 12 |