Pipe Material:
12", 8", 6" U.S. Pipe DIP, CL 350
FH Gate Valve = 6" American Flow Control
CCW-on 21 Turns

8" C900 PVC DR14 National

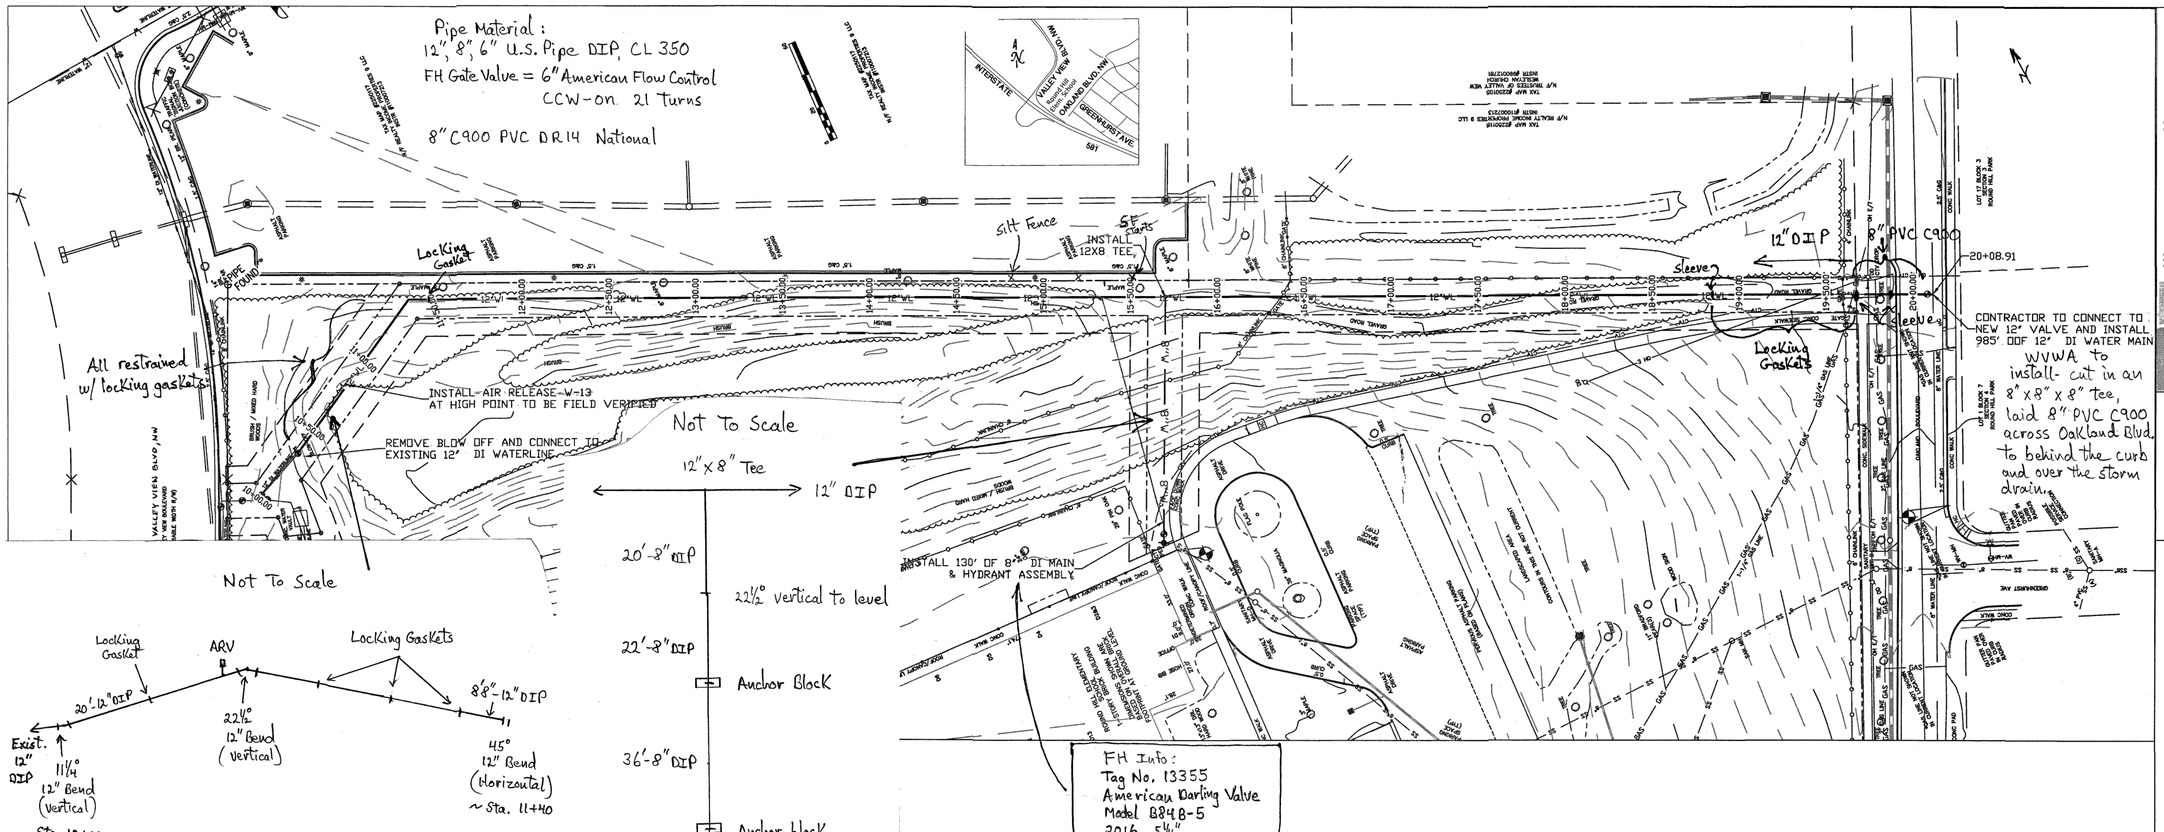

WESTERN VIRGINIA WATER AUTHORITY
ENGINEERING SERVICES
601 S JEFFERSON ST, SUITE 300
ROANOKE, VA 24011
540-853-5641 or 540-853-5770

OAKLAND WATER
Round Hill School Water Line Extension

PLAN & PROFILE
Oakland Water

Awarded Contract

Rev	Description	Date	By

Designed: AAS
Drawn: AAS
Checked:
Approved:
Date: 6-2-16
Project:

1
Sheet 1 of 1

As-Builts Substantial Completion 8.19.16 K. Winslow