12184comp-05-pp02.plt

OSSMH 3' FROM ℄

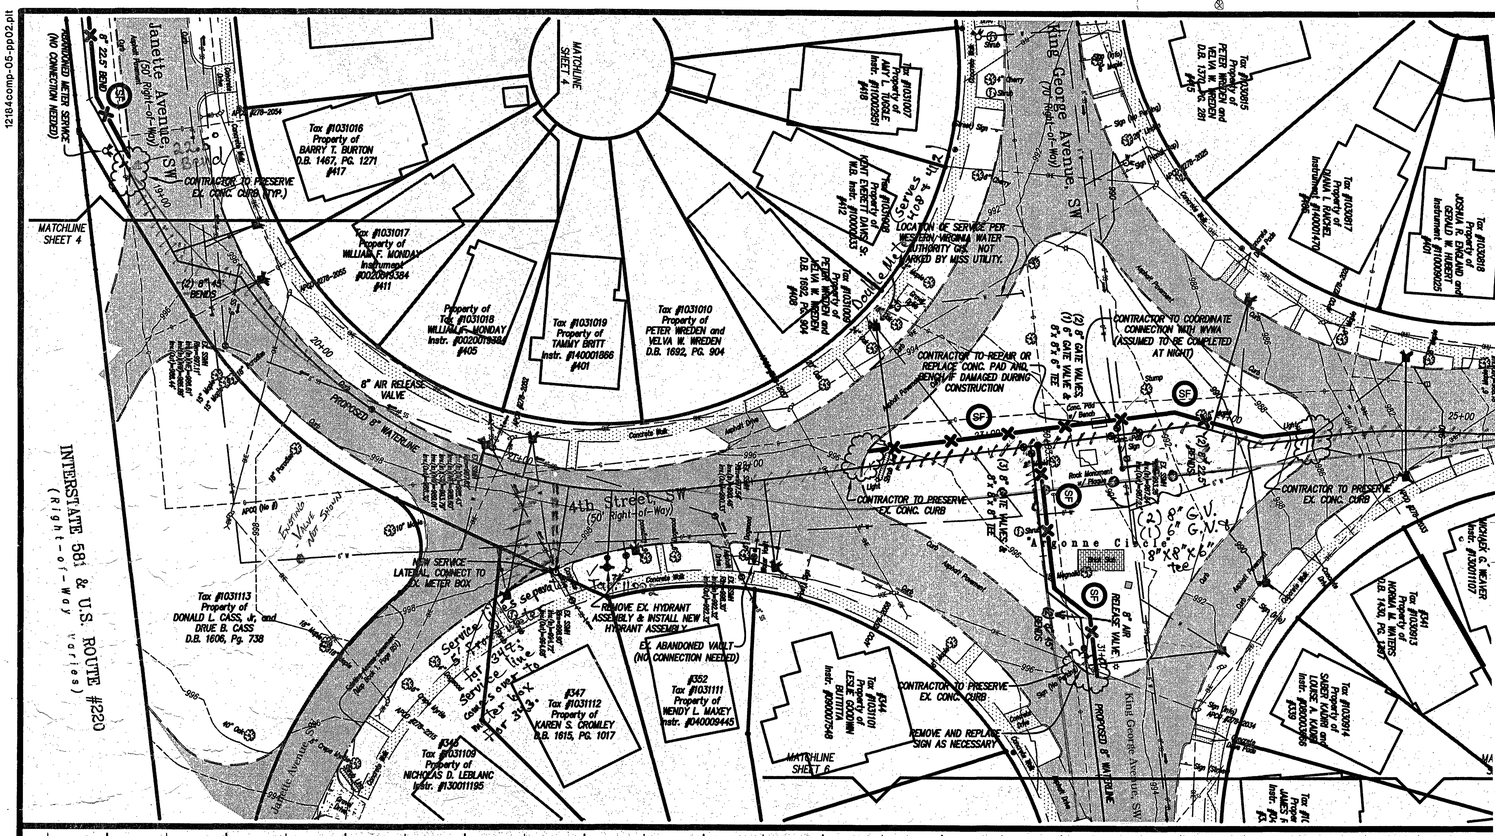

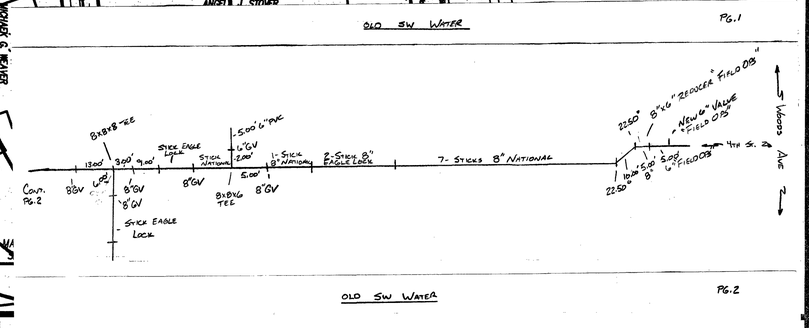

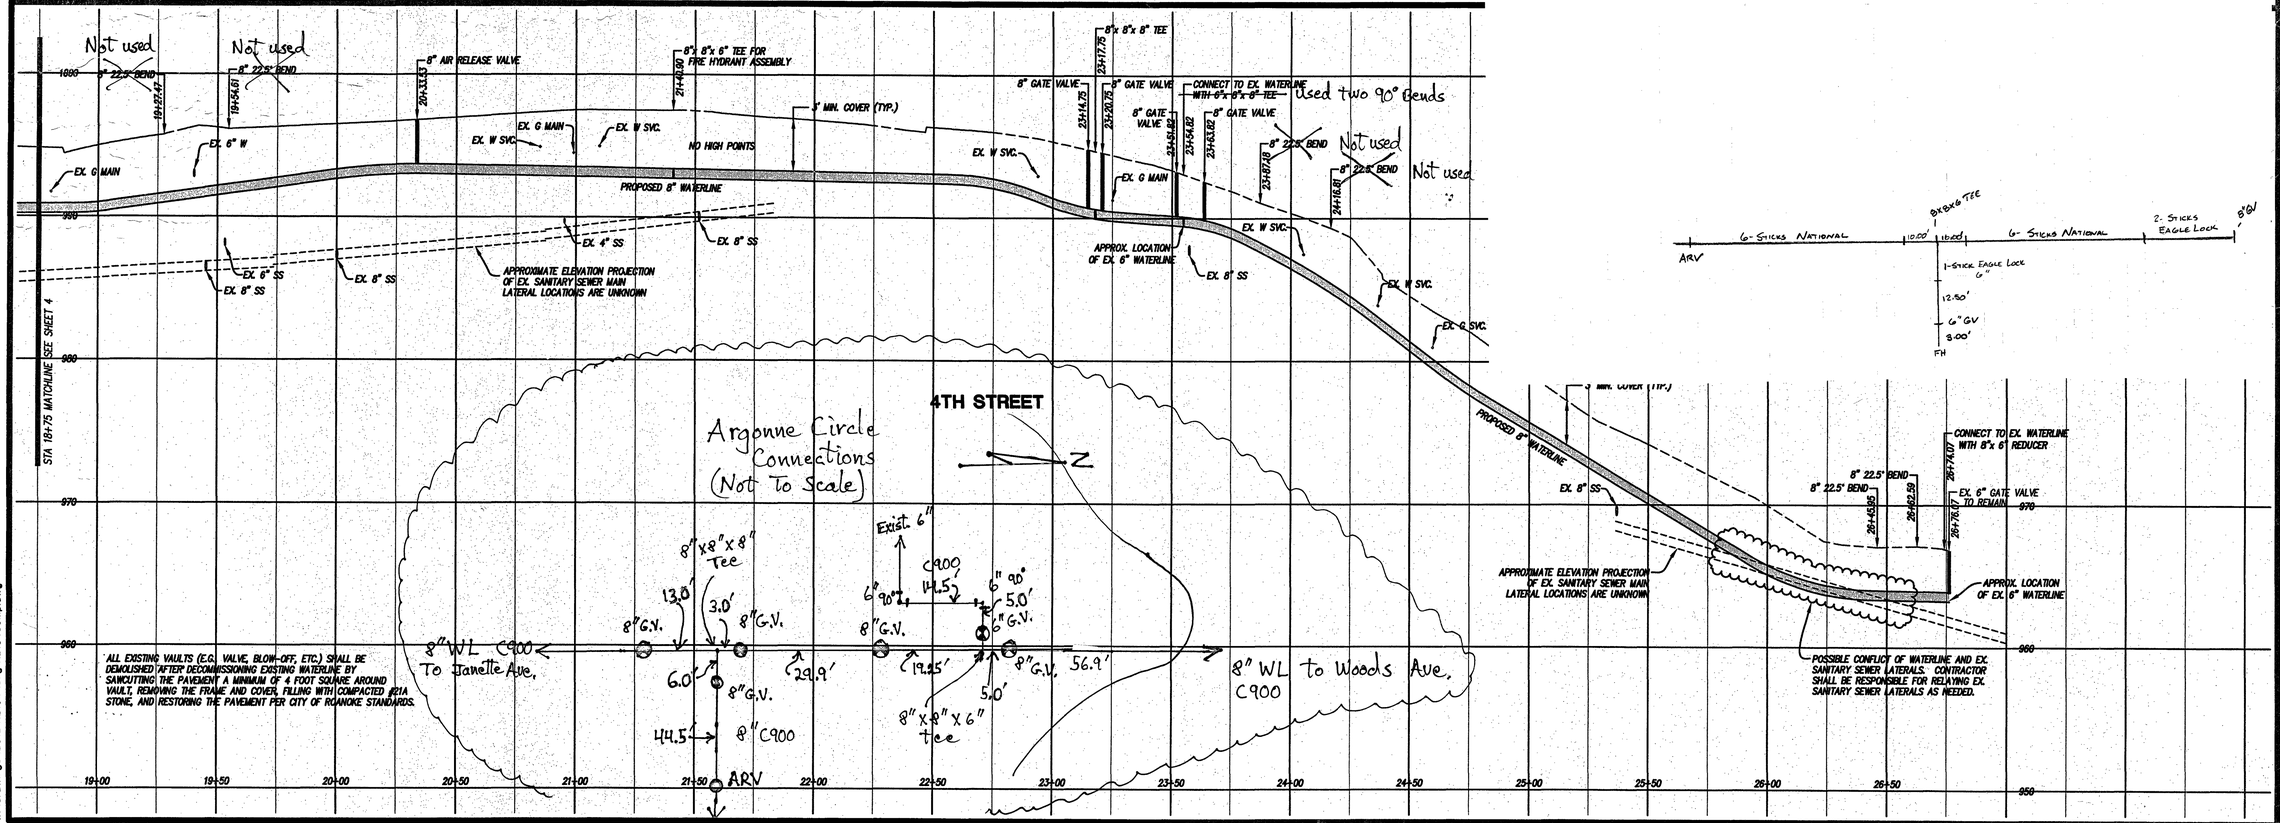

LUMSDEN ASSOCIATES, P.C.
ENGINEERS-SURVEYORS-PLANNERS
ROANOKE, VIRGINIA

4664 BRAMBLETON AVENUE
P.O. BOX 20669
ROANOKE, VIRGINIA 24018

PHONE: (540) 774-4411
FAX: (540) 772-9445
E-MAIL: MAIL@LUMSDENPC.COM

COMMONWEALTH OF VIRGINIA
10-2-14
B. LEE HENDERSON, JR.
Lic. No. 017591
PROFESSIONAL ENGINEER

PLAN & PROFILE 4TH STREET

OLD SOUTHWEST WATERLINE REPLACEMENTS - PHASE I

PREPARED FOR
WESTERN VIRGINIA WATER AUTHORITY
SITUATED IN
THE CITY OF ROANOKE, VIRGINIA

REVISIONS

NO.	DATE	DESCRIPTION
1		
2		
3		
4		
5		

DATE: OCTOBER 2, 2014
SCALE: (H) 1" = 30'; (V) 1" = 5'
COMMISSION NO: 12-184
SHEET 5 OF 8

w:\drawings\2012\12184\eng\12184comp.dwg

As-Built 7.2.15 Substantial Completion K. Winslow