

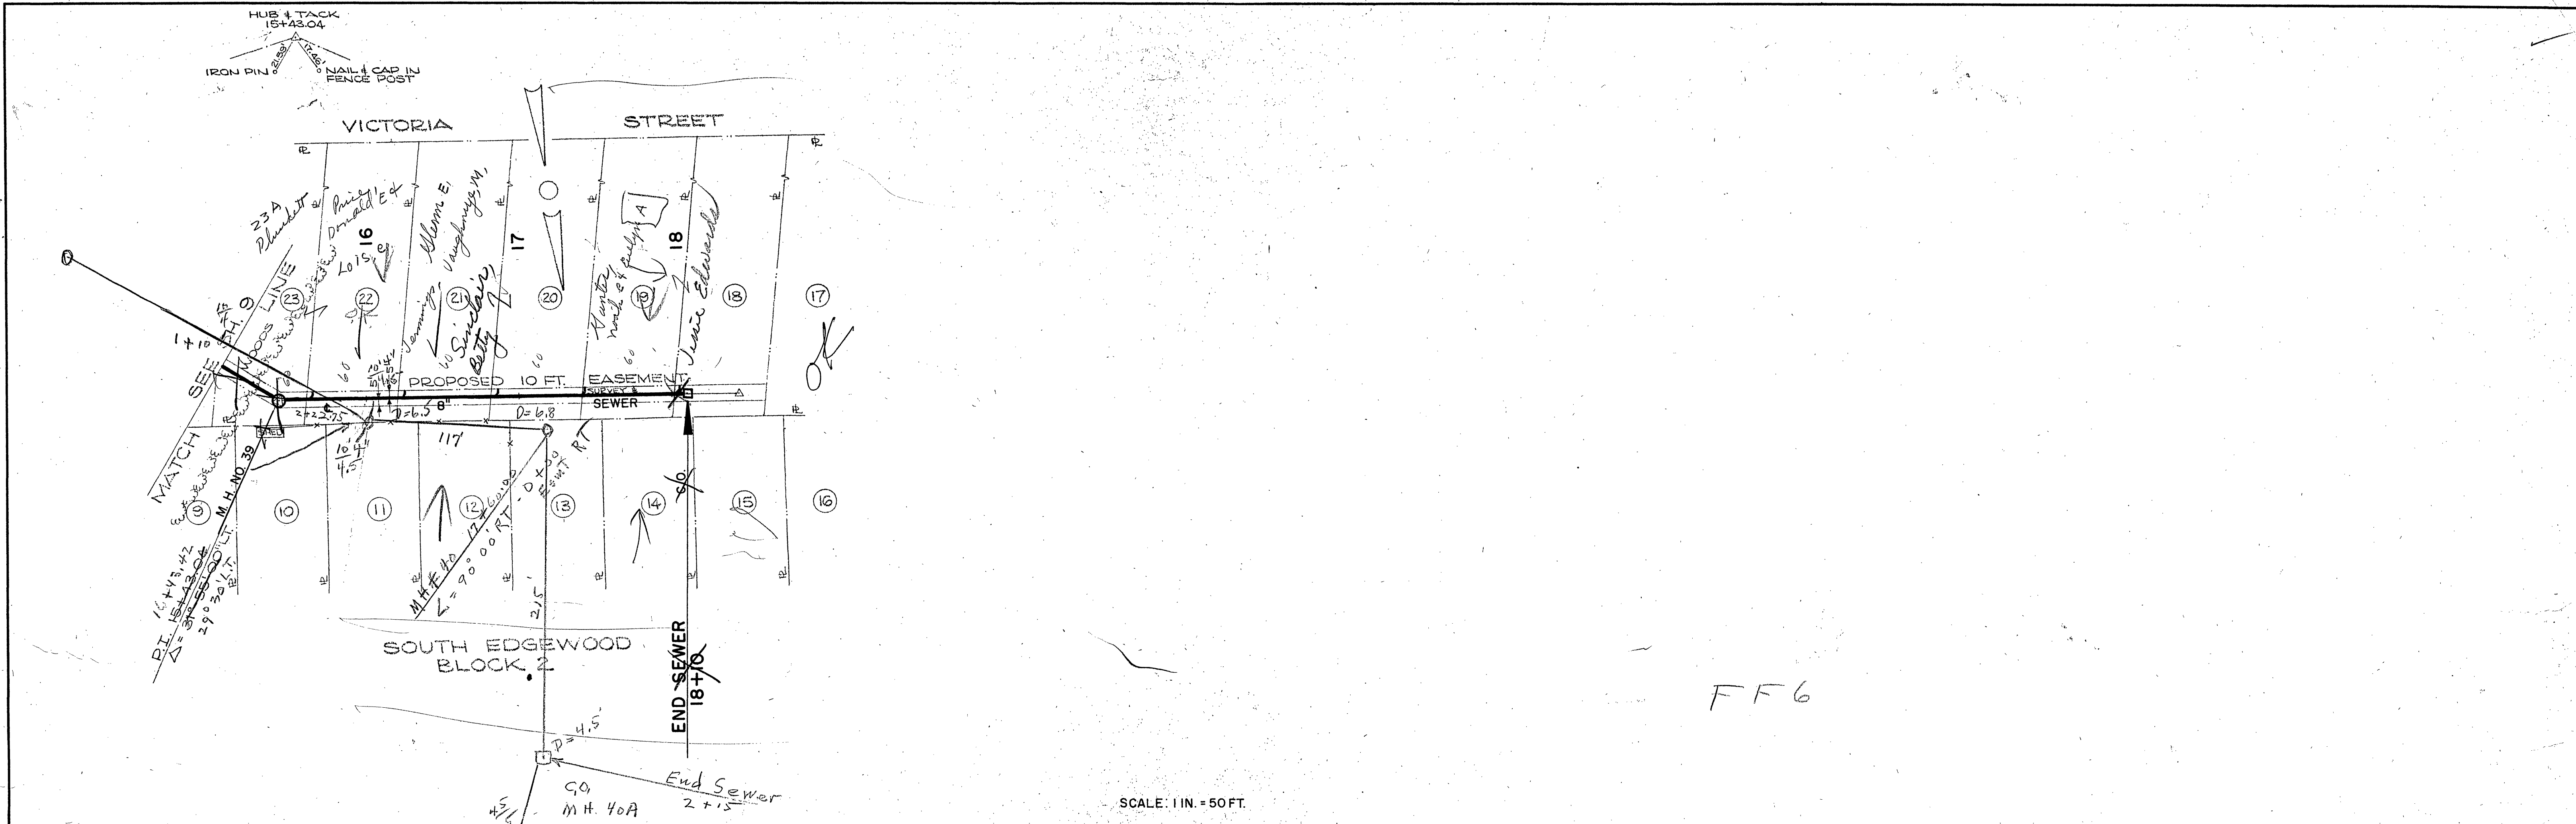


PLAN	DATE	12/15/64
	BY	W.E.C.
NOTE BOOK NO.	SURVEYED	W.E.C.
	PLOTTED	W.E.C.
NO.	GRADES CHECKED	W.E.C.
	STRUCTURE NOTATIONS	CHD.

PROFILE	DATE	12/15/64
	BY	W.E.C.
NOTE BOOK NO.	SURVEYED	W.E.C.
	PLOTTED	W.E.C.
NO.	GRADES CHECKED	W.E.C.
	STRUCTURE NOTATIONS	CHD.

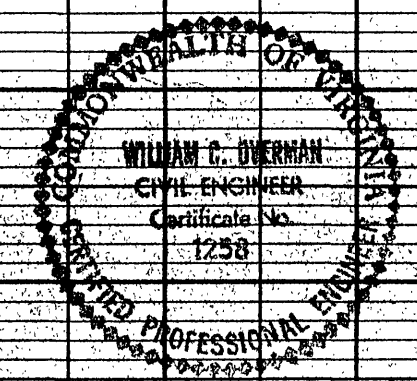

FF6

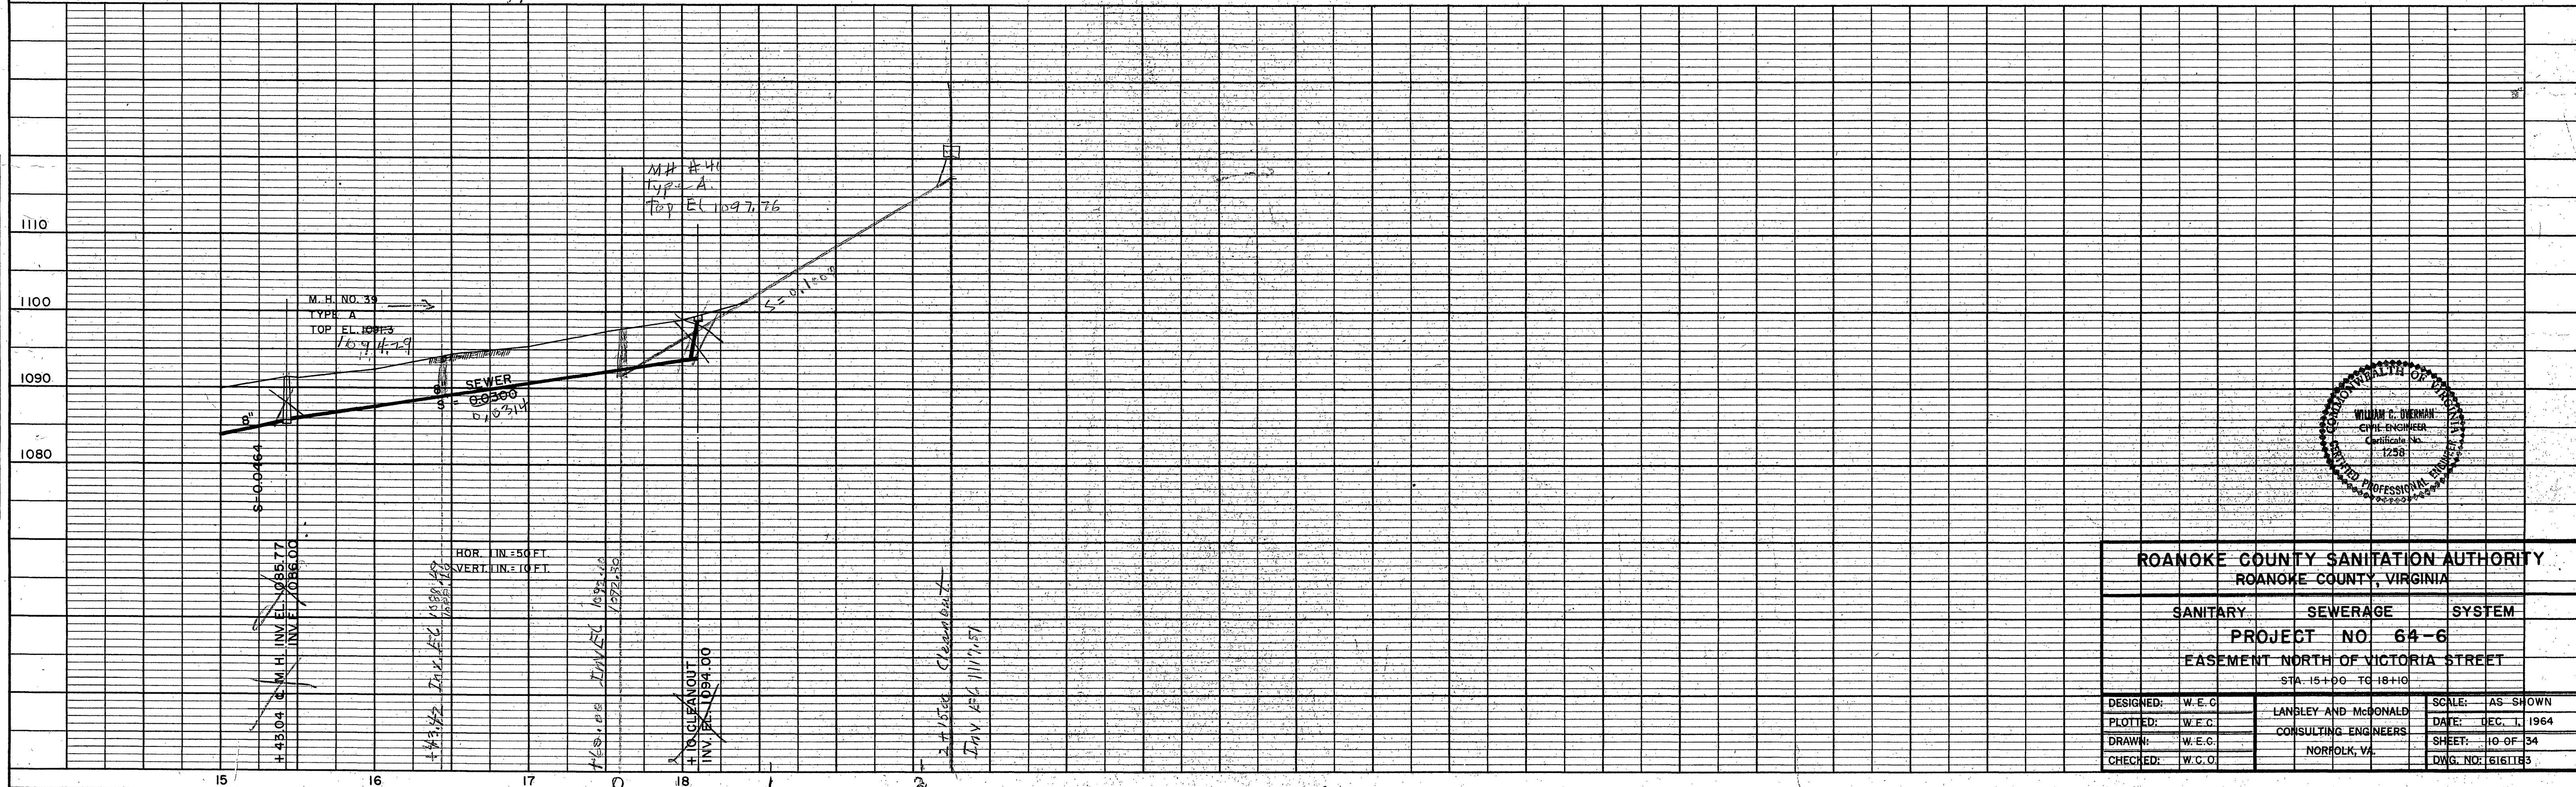

ROANOKE COUNTY SANITATION AUTHORITY ROANOKE COUNTY, VIRGINIA		
SANITARY	SEWERAGE	SYSTEM
PROJECT NO. 64-6		
EASEMENT NORTH OF VICTORIA STREET		
STA. 15+00 TO 18+10		
DESIGNED: W.E.C.	LANGLEY AND McDONALD	SCALE: AS SHOWN
PLOTTED: W.E.C.	CONSULTING ENGINEERS	DATE: DEC. 1, 1964
DRAWN: W.E.C.	NORFOLK, VA.	SHEET: 10 OF 34
CHECKED: W.C.O.		DWG. NO: 61611B3