



DATE	11/14/64
BY	W.B.
PLAN	SURVEYED PLOTTED NOTE BOOK ALIGNMENT CHECKED RT. OF WAY CHECKED
NO.	

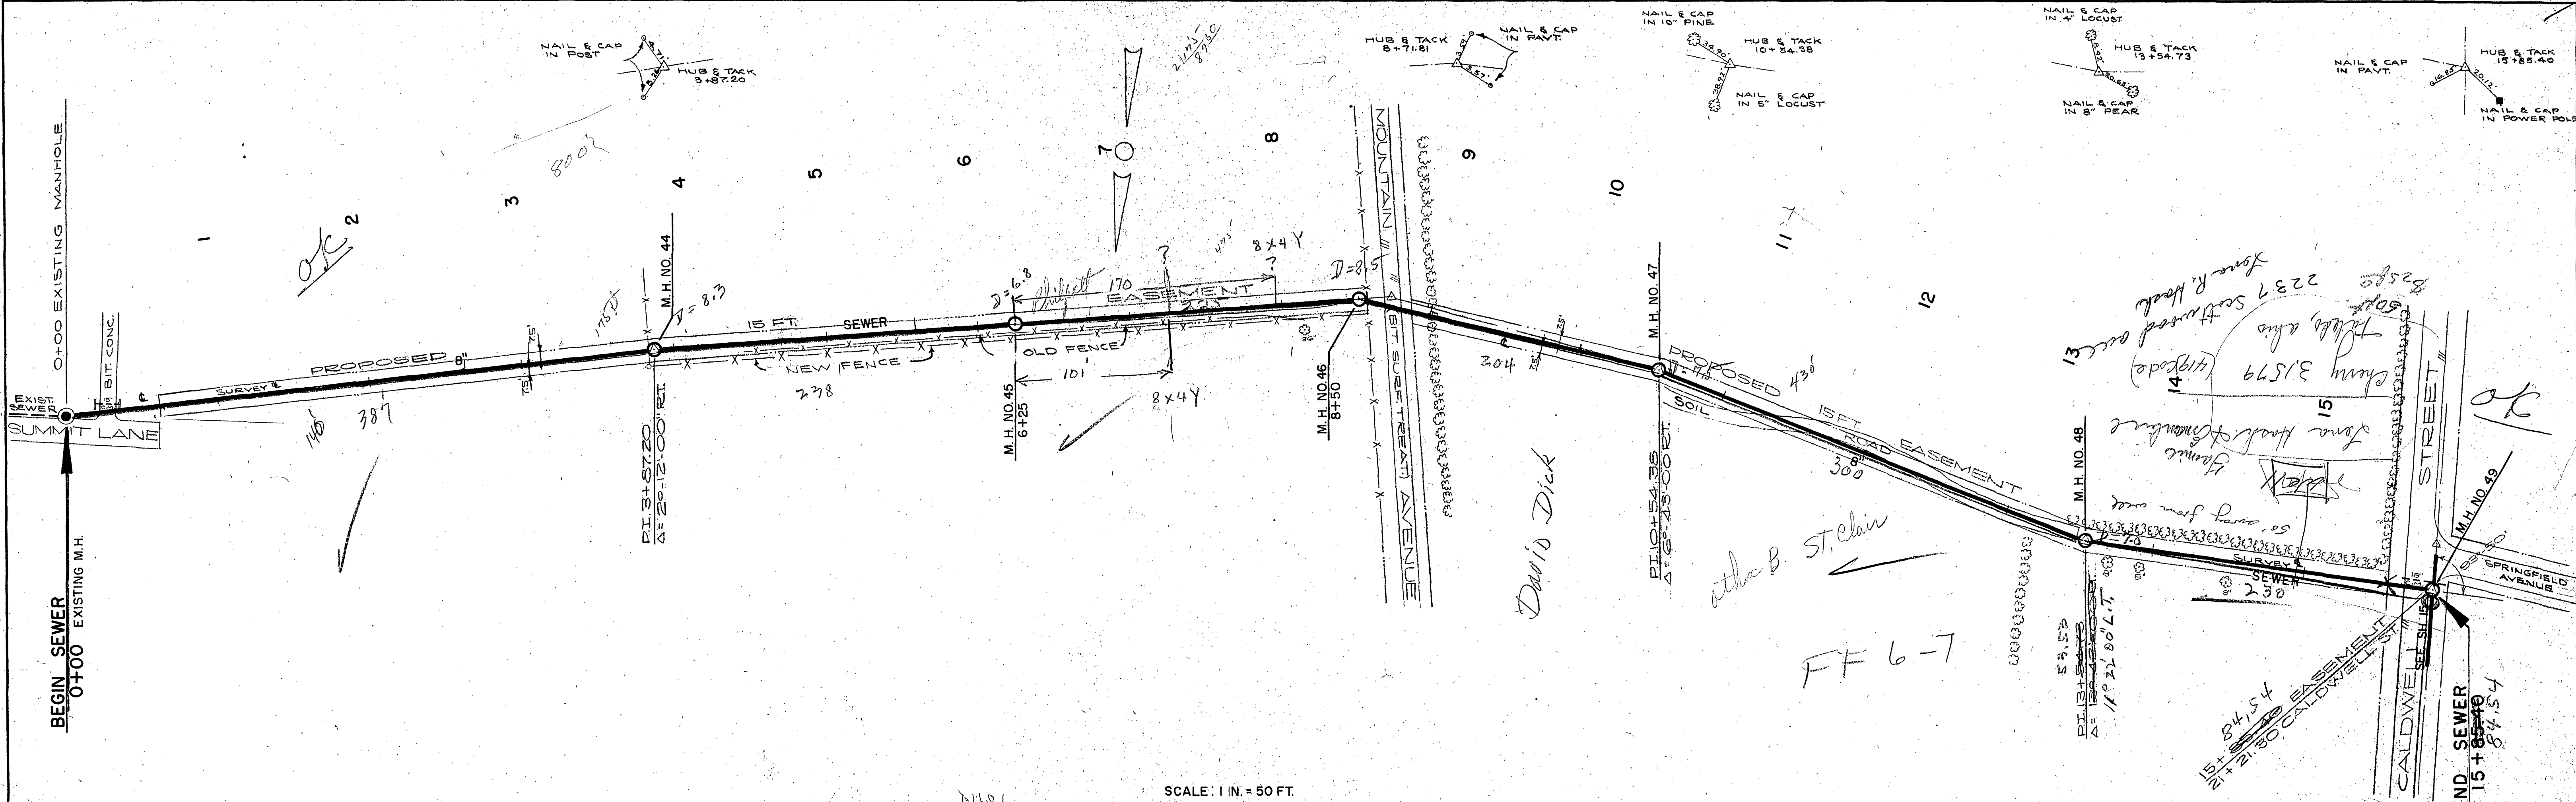

SCALE: 1 IN. = 50 FT.

DATE	11/14/64
BY	W.B.
PROFILE	SURVEYED PLOTTED NOTE BOOK GRADES CHECKED B. N. NOTED STRUCTURE NOTATIONS CHECKED
NO.	

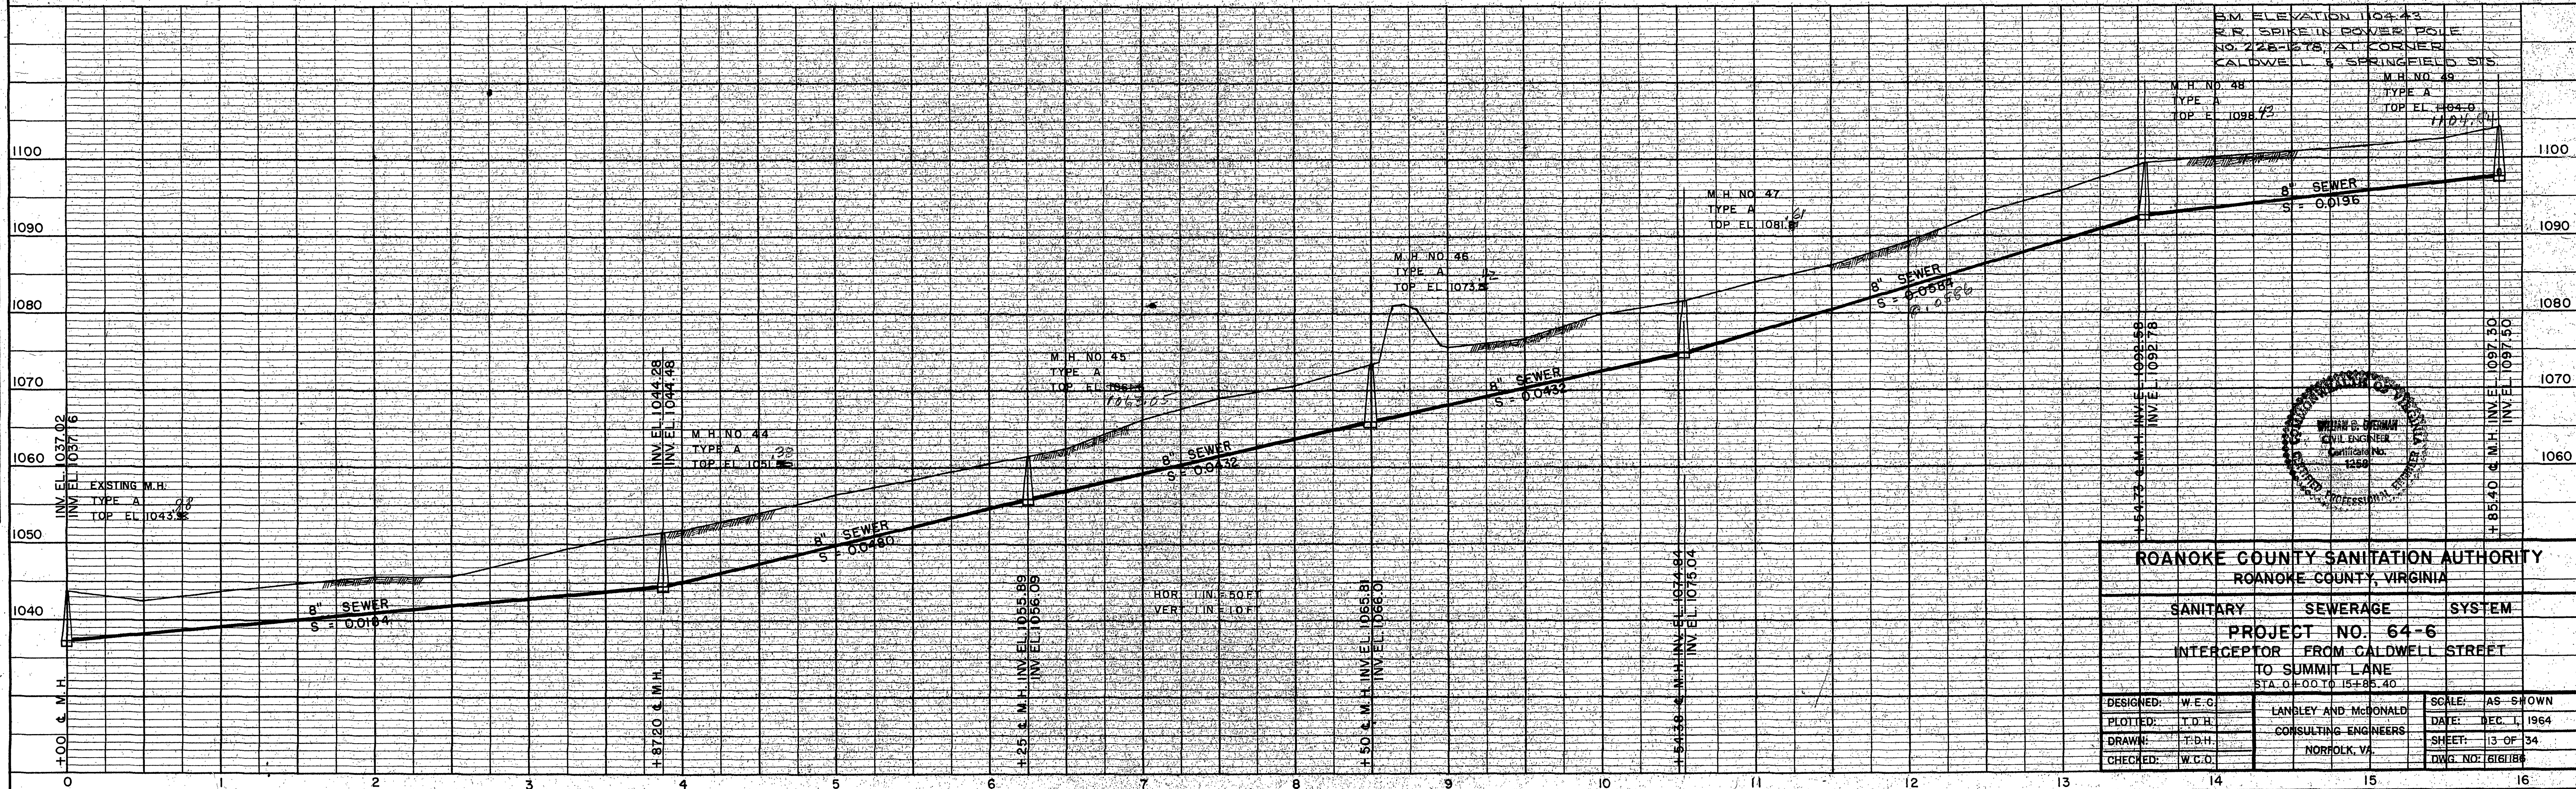

ROANOKE COUNTY SANITATION AUTHORITY ROANOKE COUNTY, VIRGINIA		
SANITARY	SEWERAGE	SYSTEM
PROJECT NO. 64-6		
INTERCEPTOR FROM CALDWELL STREET		
TO SUMMIT LANE		
STA. 0+00 TO 15+85.40		
DESIGNED: W.E.G.	LANGLEY AND McRONALD	SCALE: AS SHOWN
PLOTTED: T.D.H.	CONSULTING ENGINEERS	DATE: DEC. 1, 1964
DRAWN: T.D.H.	NORFOLK, VA.	SHEET: 13 OF 34
CHECKED: W.C.D.		DWG. NO. 616186