





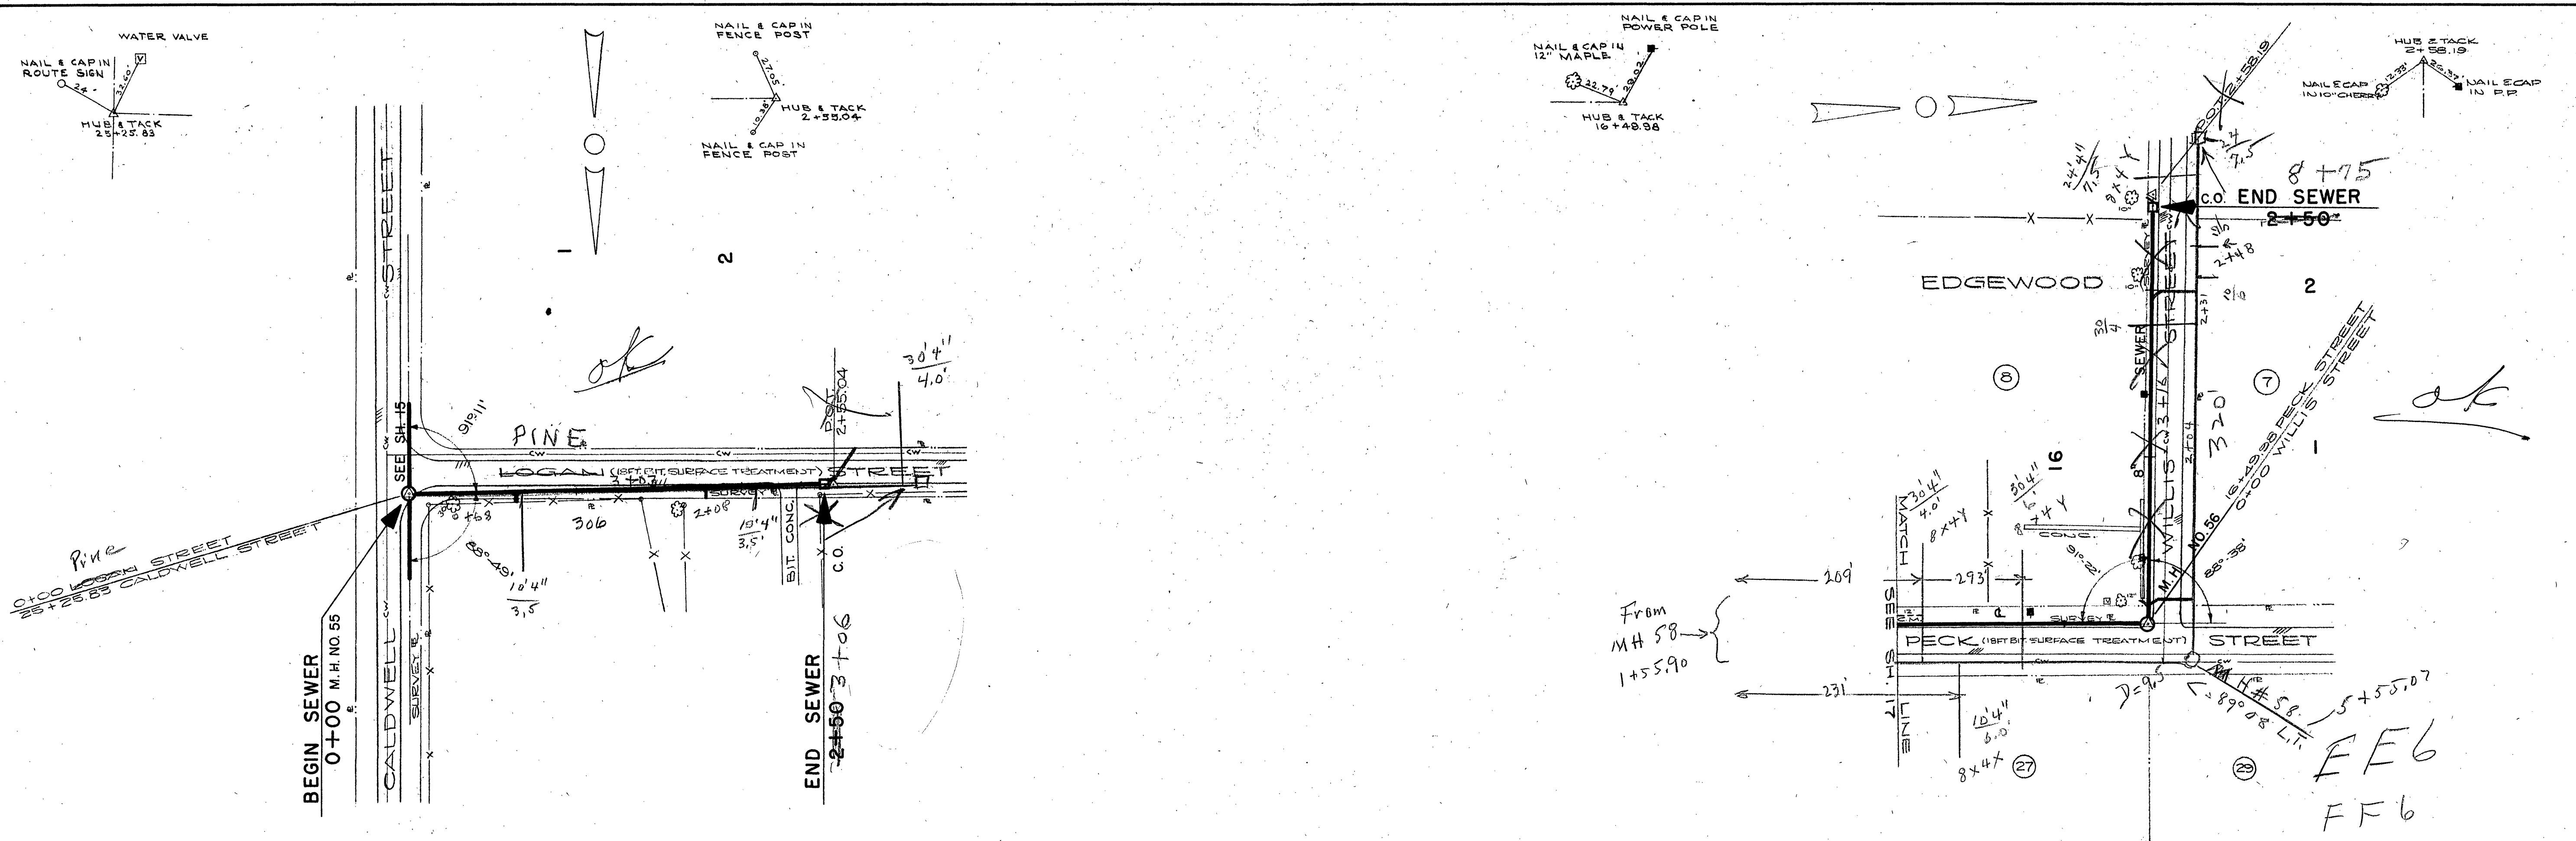

SCALE: 1 IN. = 50 FT.

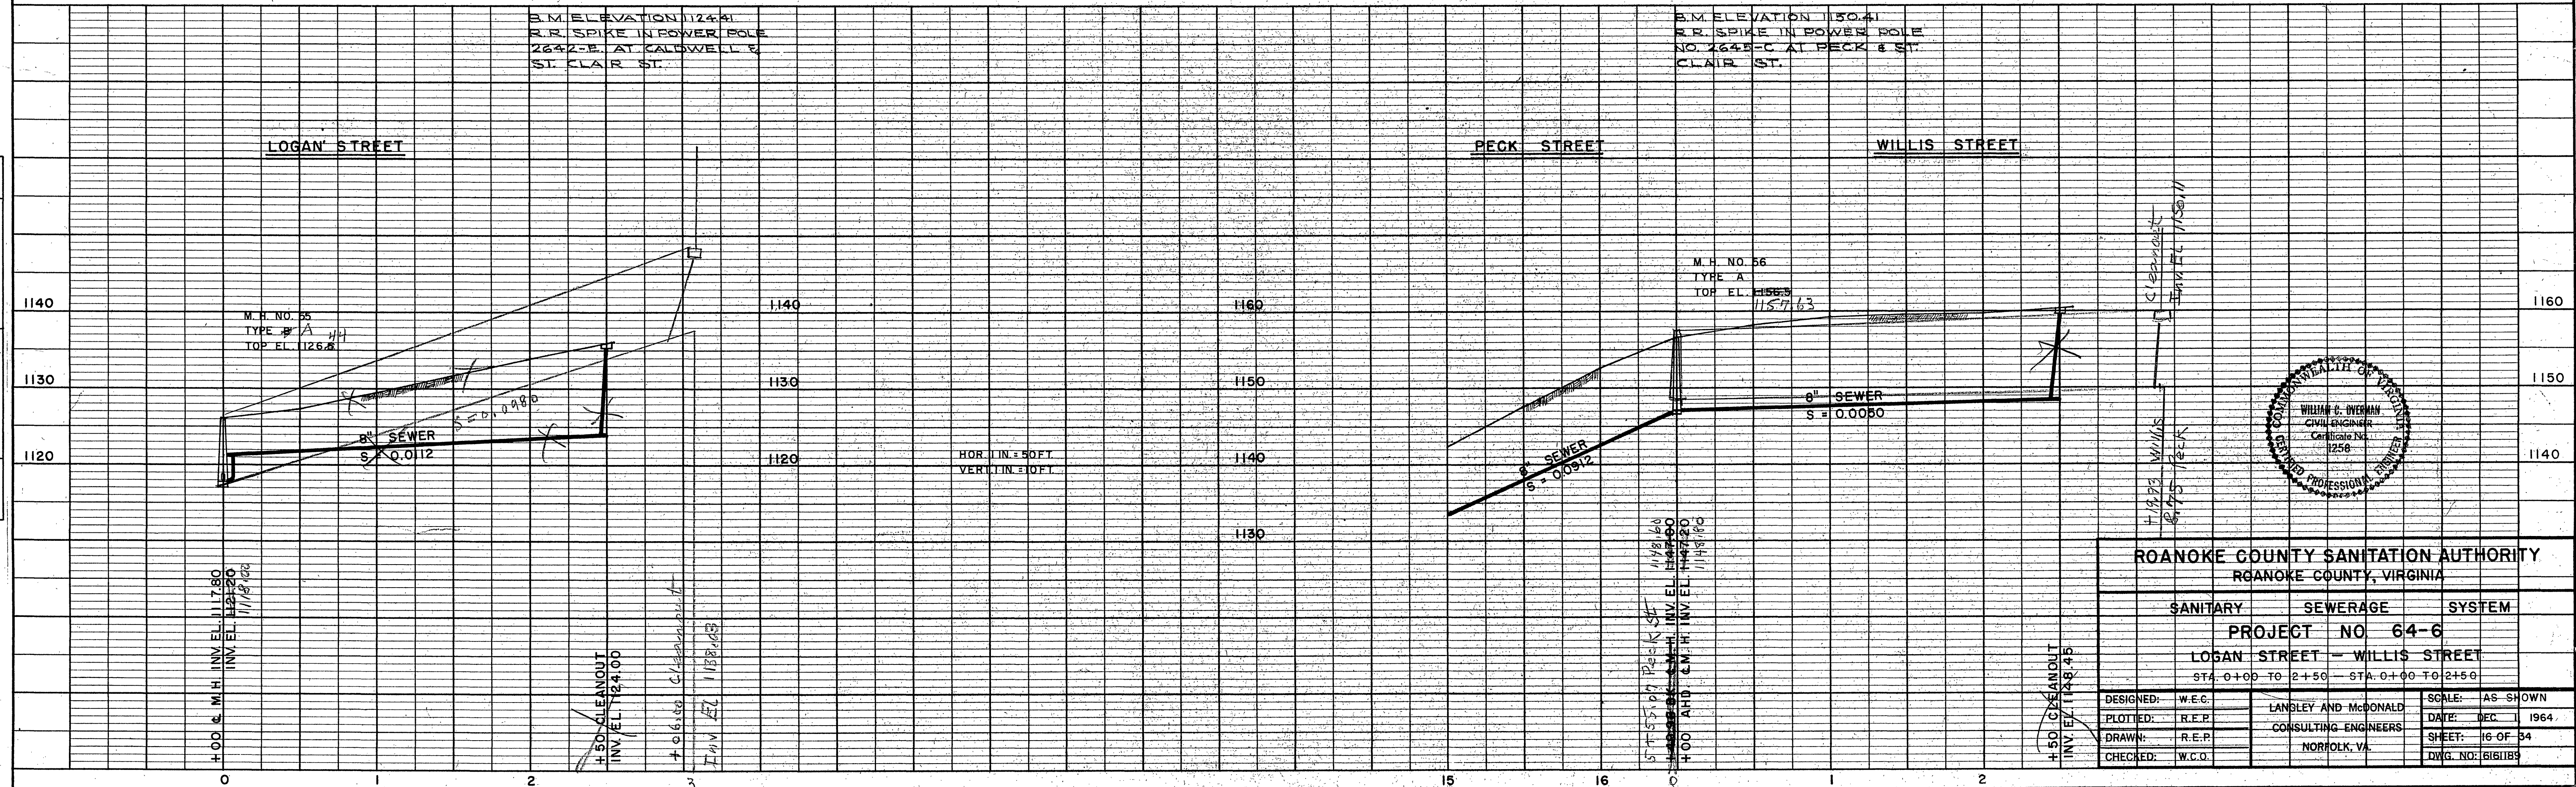

ROANOKE COUNTY SANITATION AUTHORITY ROANOKE COUNTY, VIRGINIA		
SANITARY	SEWERAGE	SYSTEM
PROJECT NO. 64-6		
LOGAN STREET - WILLIS STREET		
STA. 0+00 TO 2+50		STA. 0+00 TO 2+50
DESIGNED: W.C.C.	LANDLEY AND McDONALD	SCALE: AS SHOWN
PLOTTED: R.E.P.	CONSULTING ENGINEERS	DATE: DEC. 1964
DRAWN: R.E.P.	NORFOLK, VA.	SHEET: 16 OF 54
CHECKED: W.C.C.		DWG. NO: 616185