


EE 6-7

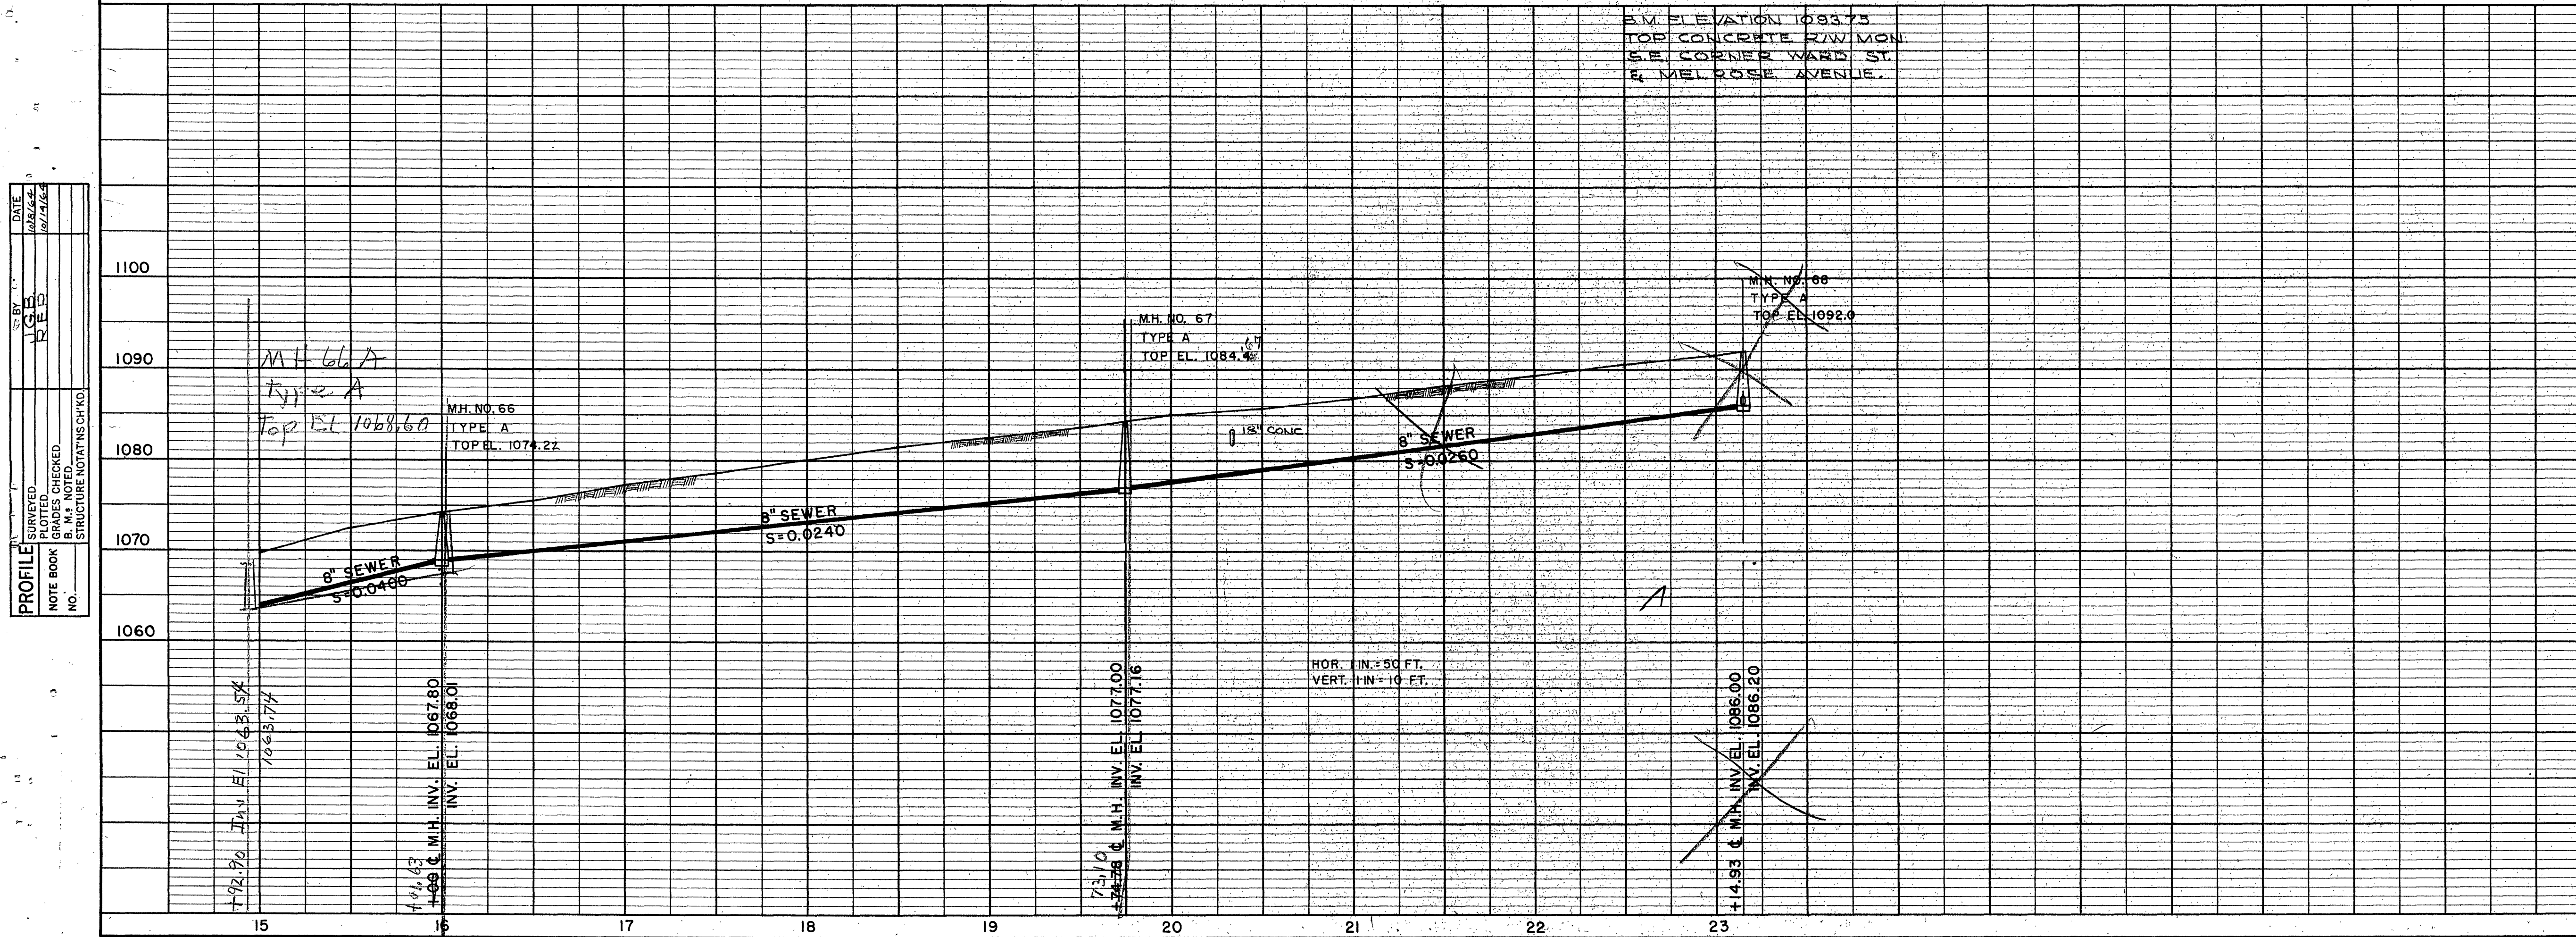

ROANOKE COUNTY SANITATION AUTHORITY ROANOKE COUNTY, VIRGINIA		
SANITARY	SEWERAGE	SYSTEM
PROJECT NO. 64-6		
MELROSE AVENUE - SOUTH SIDE		
STA. 15+00 TO 23+93.76		
DESIGNED: W.E.G.	LANGLEY AND McDONALD	SCALE: AS SHOWN
PLOTTED: R.E.P.	CONSULTING ENGINEERS	DATE: DEC. 1, 1964
DRAWN: R.E.P.	NORFOLK, VA.	SHEET: 20 OF 34
CHECKED: W.C.O.		DWG. NO: 61619