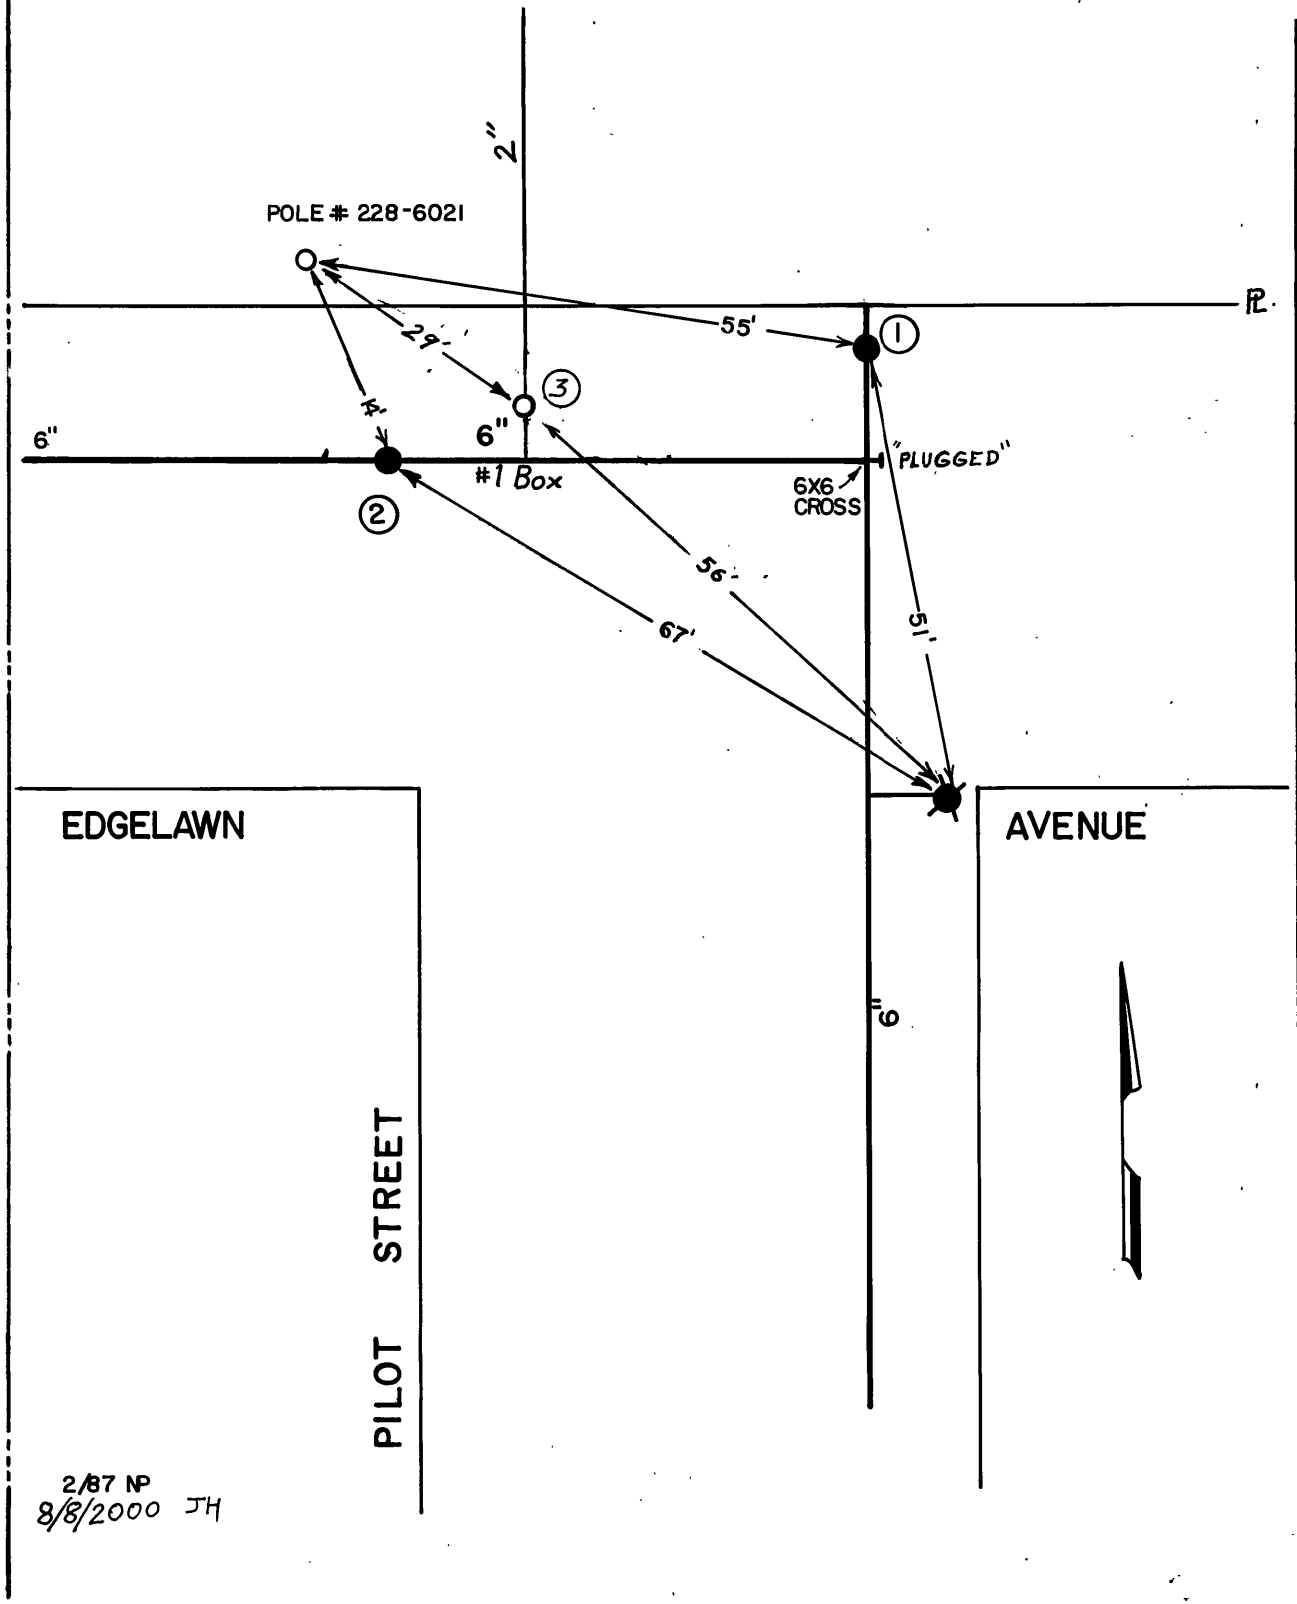

DATE	NO.	SIZE	MAKE	OPEN	TURNS
3-77	1	6"	MUELLER	R	
3-77	2	6"	MUELLER	R	
3-77	3	2"	MISC.		

CITY OF ROANOKE—WATER DEP'T

VALVE DIAGRAM

EDGELAWN AVENUE &

PILOT STREET

N. W.

SEC. MAP 610

DATE PAGE NO.