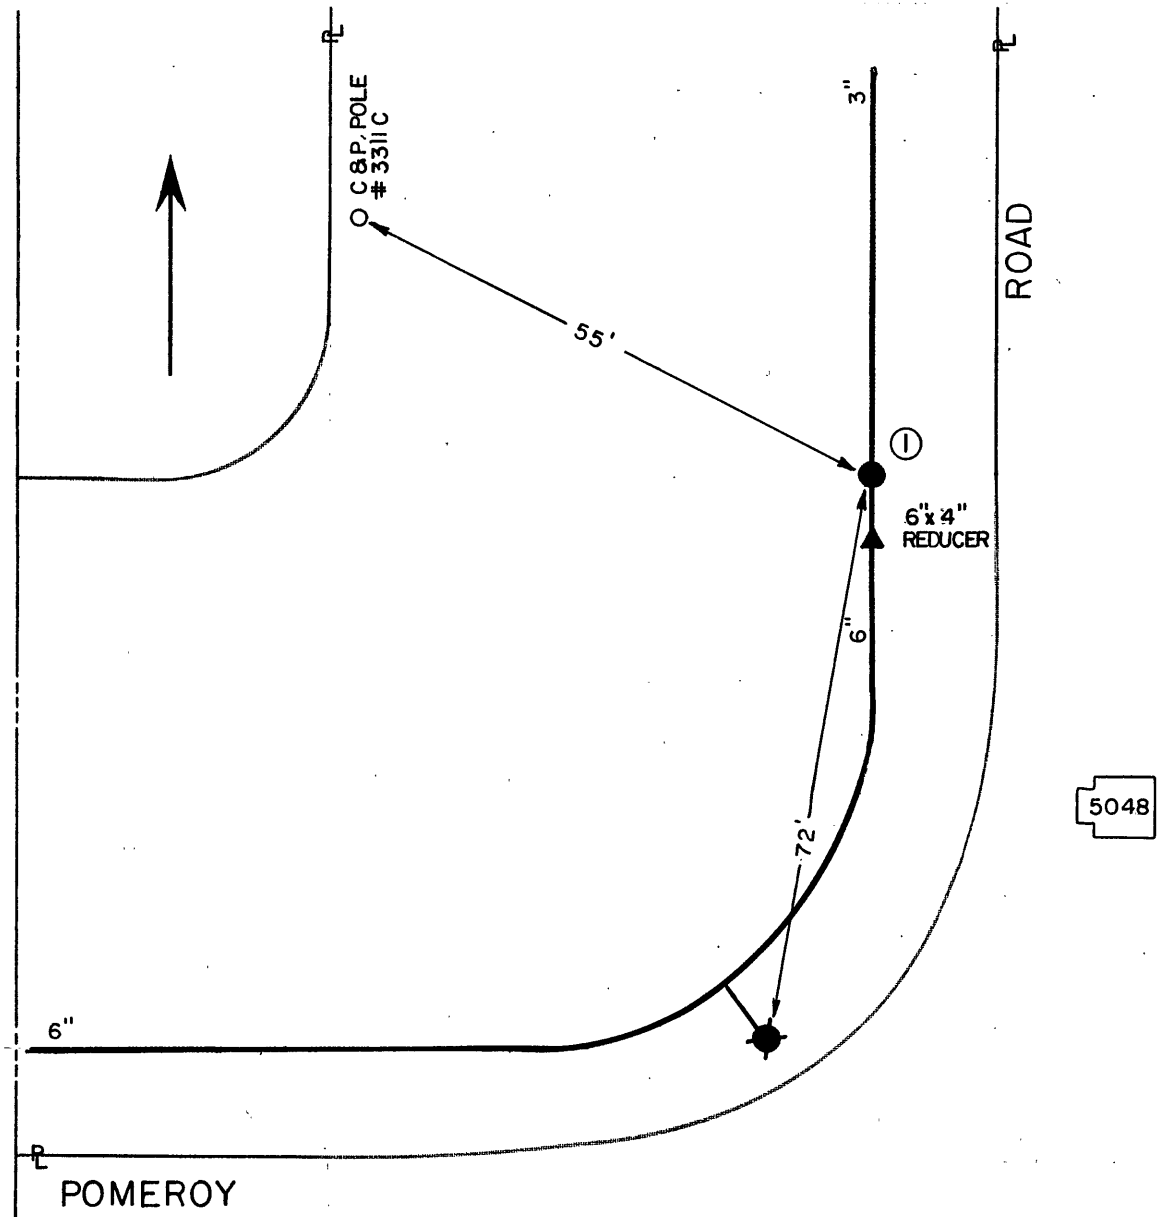

5048

DATE	NO.	SIZE	MAKE	OPEN	TURNS
1998	1	4"	AM.DARLING	R	15

CITY OF ROANOKE—WATER DEP'T

VALVE DIAGRAM

POMEROY ROAD

5000 BLOCK

SEC. MAP 606 N.W.

DATE PAGE NO.

10/98 NP