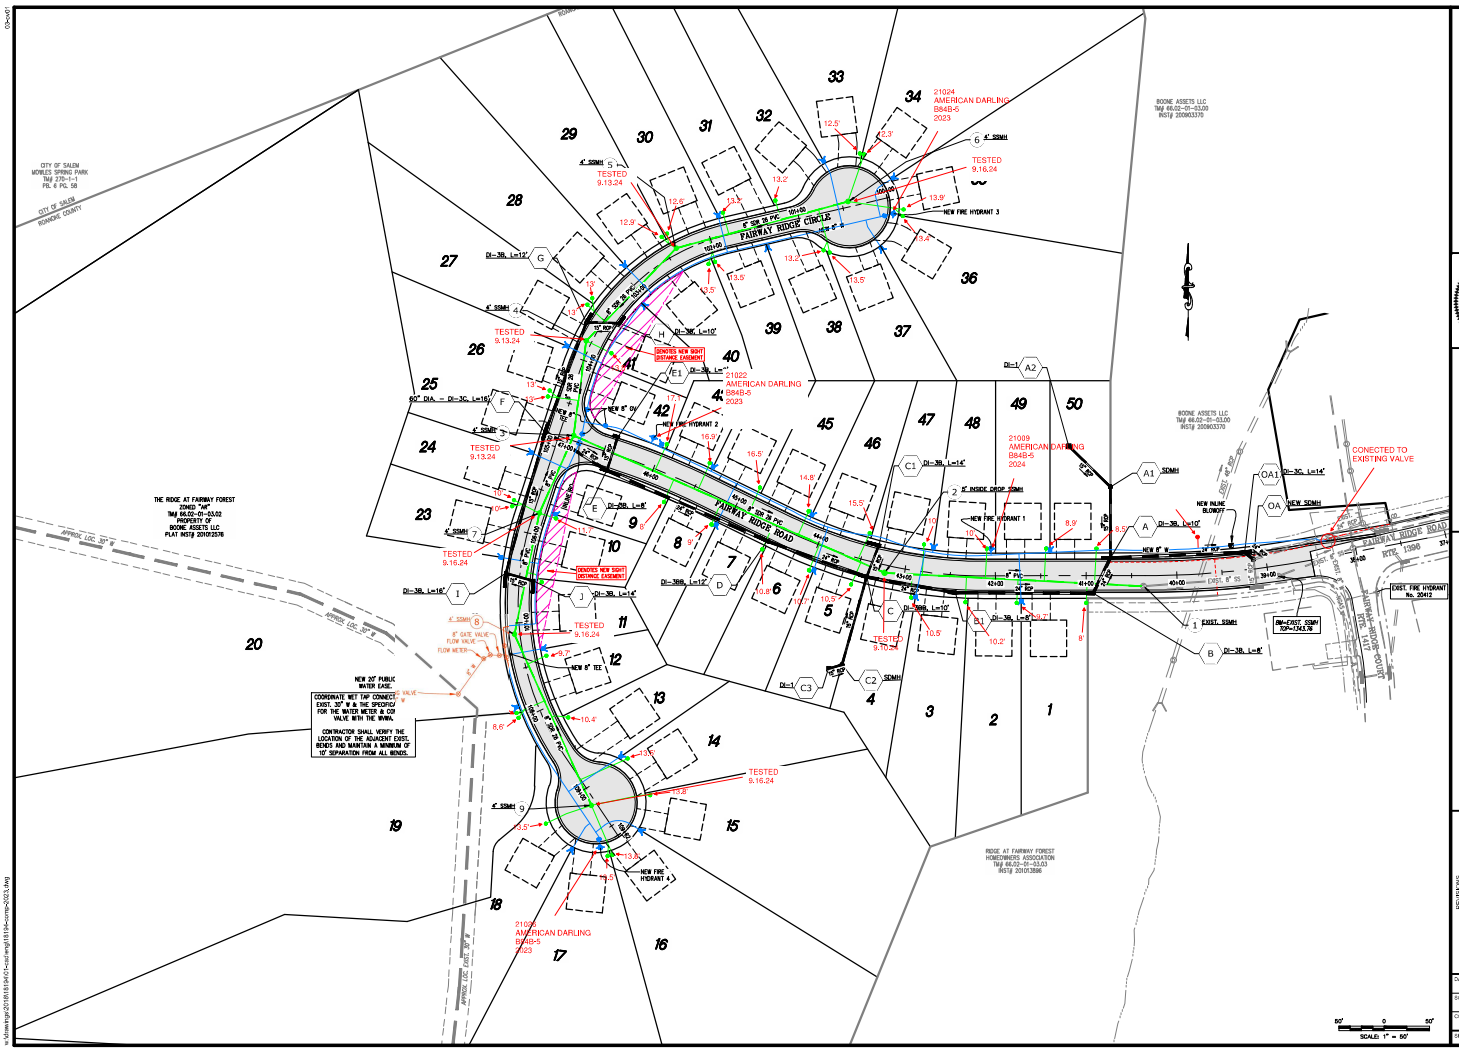

Lumsden Associates, P.C.
ENGINEERS | SURVEYORS | PLANNERS
4984 BRAMBLETON AVENUE
ROANOKE, VIRGINIA 24018
PHONE: (540) 772-4411
FAX: (540) 772-4412
EMAIL: MAIL@LUMSDENPC.COM

COMMONWEALTH OF VIRGINIA
ANDREW P. LUMSDEN
Lic. No. 000818
PROFESSIONAL ENGINEER

DEVELOPMENT OVERVIEW
AND CONSTRUCTION
PHASING

SECTION 2
RIDGE AT FAIRWAY FOREST
PREPARED FOR:
ABRE HOLDINGS, INC.
WINDSOR HILLS MAGISTERIAL DISTRICT
ROANOKE COUNTY, VIRGINIA

REVISIONS

NO.	DATE	DESCRIPTION
1	07/25/24	SEE PLAN REVISION TABLE ON SH. 2
2		
3		
4		
5		

DATE: FEBRUARY 26, 2024
SCALE: 1" = 50'
COMM.NO.: 2018-194
SHEET: 3 OF: 20

APPROVED, 8/26/2024