




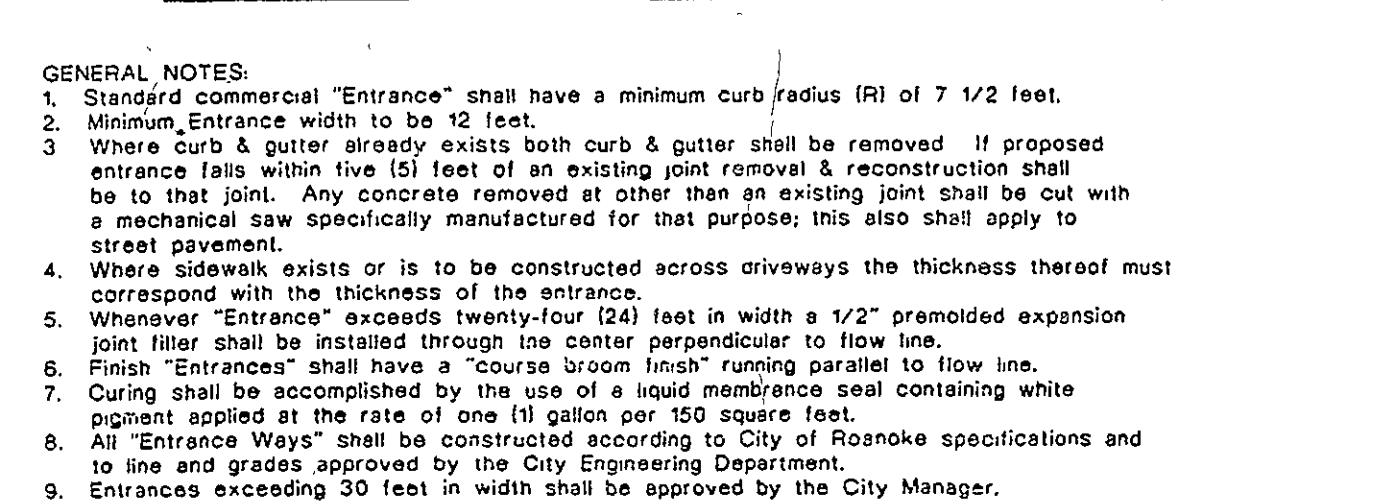

CURVE	STATION	NORTHING	EASTING	RADIUS	LENGTH
C1	PC STA = 13+26.77	3637926.69	110733561.32	70'	97.26'
	PI STA = 13+85.10	3637969.35	11073521.54		
	PT STA = 14+24.03	3637937.93	11073472.40		
C2	PC STA = 24+39.03	3637824.99	11073252.20	70'	24.91'
	PI STA = 24+51.62	3637816.21	11073241.60		
	PT STA = 24+63.94	3637861.54	11073229.29		
C3	PC STA = 26+36.33	3637579.08	11073060.81	100'	121.45'
	PI STA = 27+05.85	3637564.38	11072992.86		
	PT STA = 27+57.82	3637622.94	11072955.41		

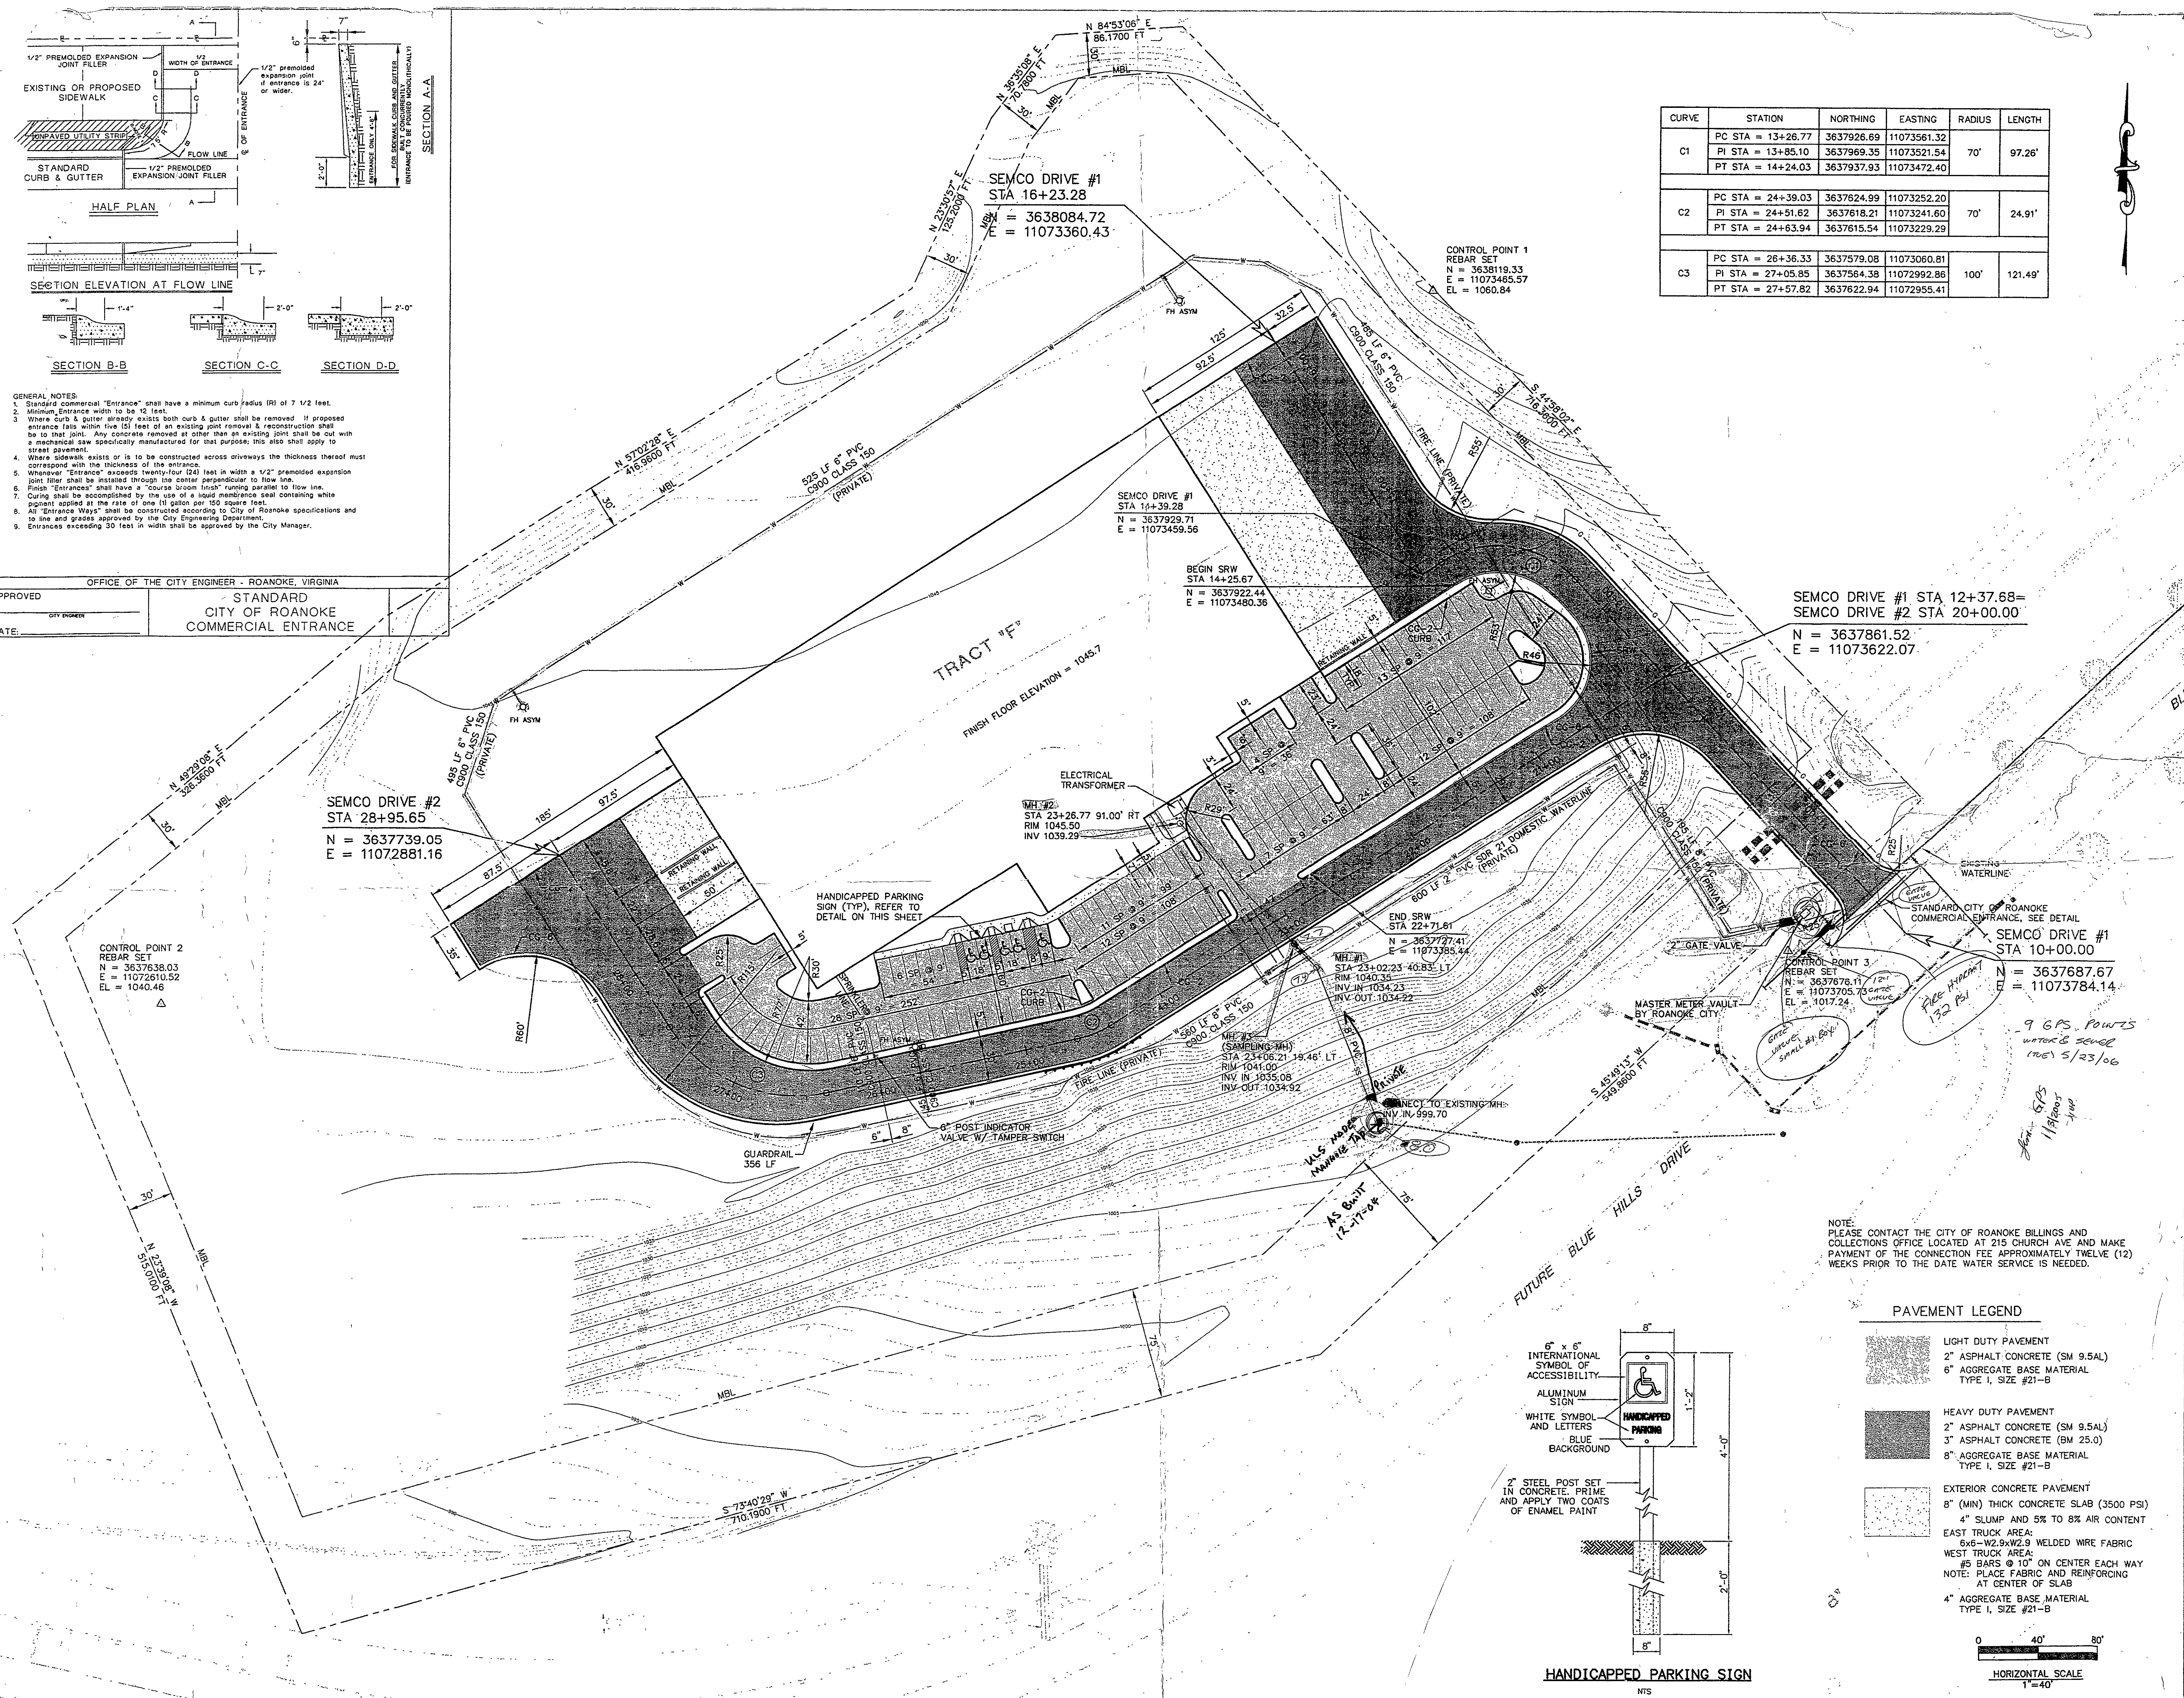

SEMCO INC. TO GPS
NEW MANUFACTURING FACILITY

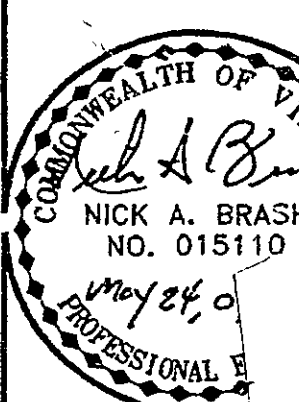

L.A. Gates
Company
ENGINEERS & CONSULTANTS
ROANoke, VA BECKLEY, WV
306 MARVEL STREET

SHEET TITLE	1
UTILITIES AND DIMENSIONAL LAYOUT	

DESIGNED	NAB
DRAWN	RLM
PROJECT NUMBER	04.001
DATE	MAY 24, 2004
CADD-FILE	
SHEET	

C-3