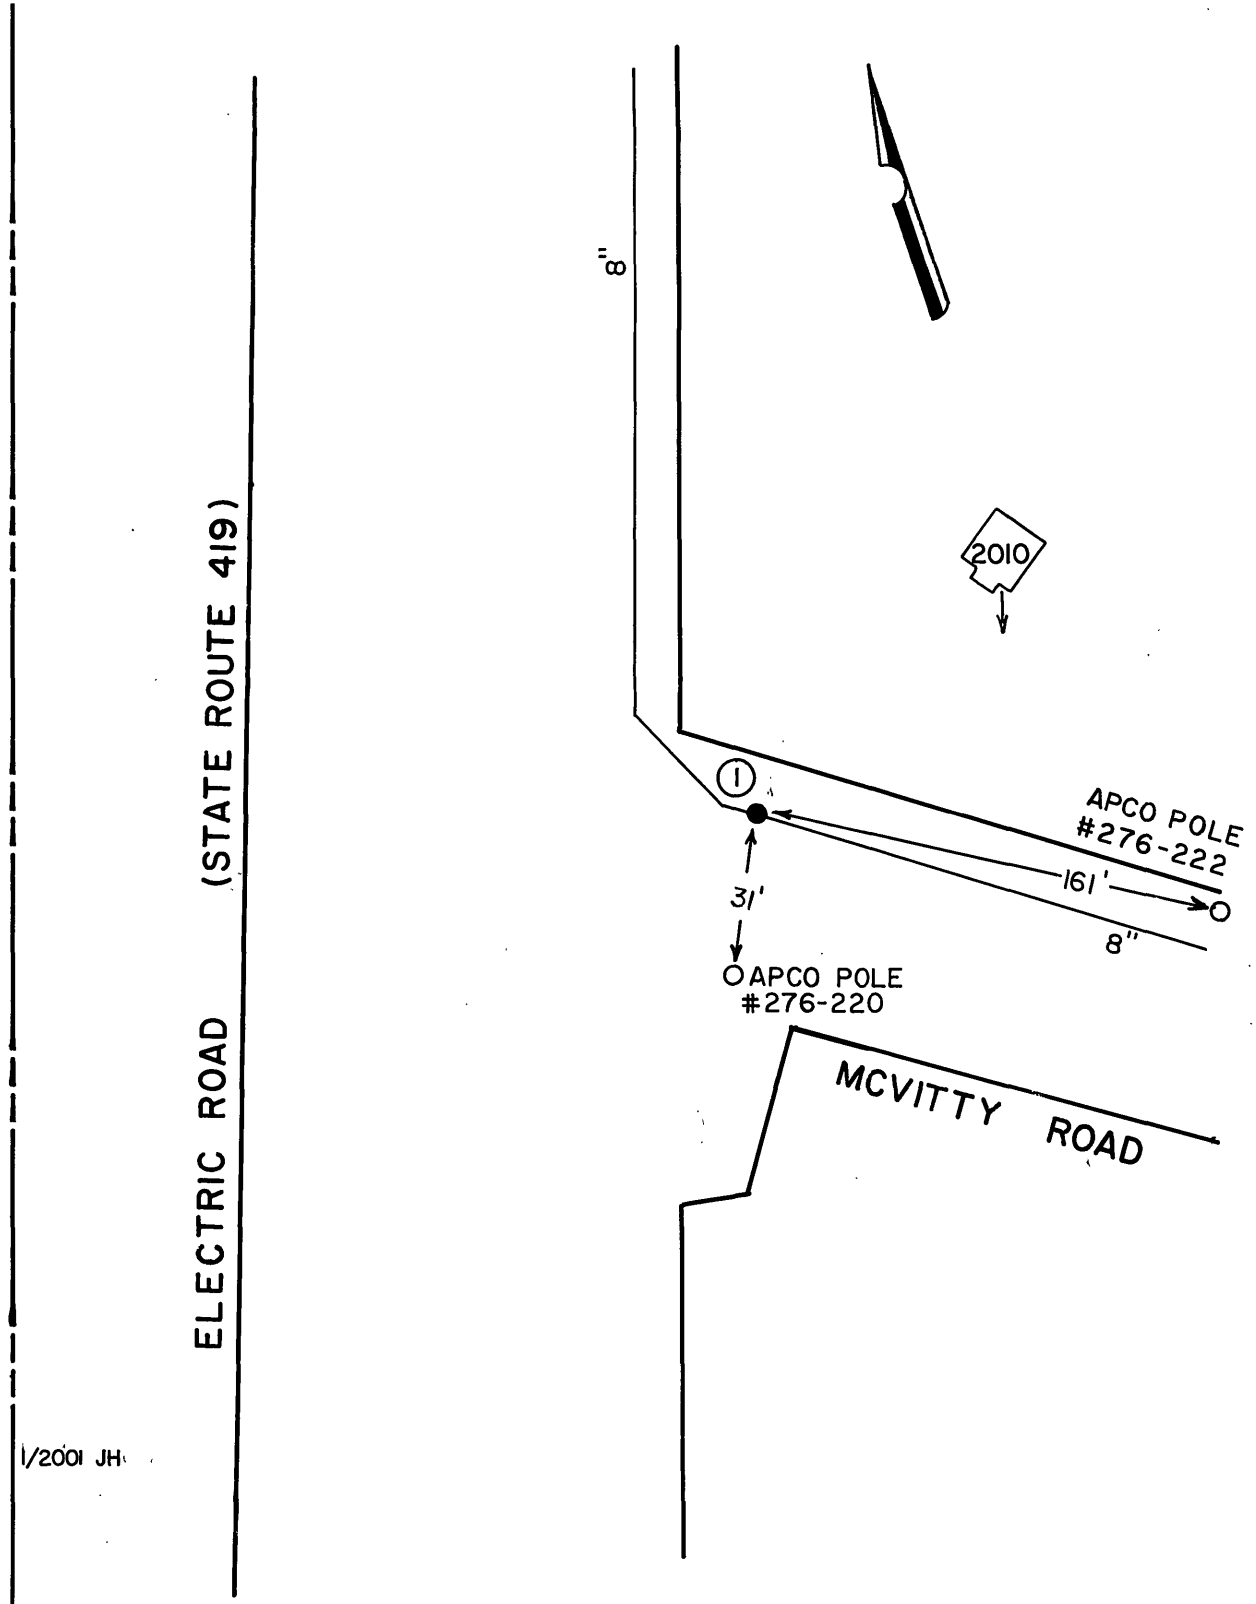

DATE	NO.	SIZE	MAKE	OPEN	TURNS
3-81	1	8"	MUELLER	R	

CITY OF ROANOKE - WATER DEP'T.

VALVE DIAGRAM

ELECTRIC ROAD (RT. 419) & MCVITTY ROAD

SEC. MAP 510 S.W.

DATE: PAGE NO.

1/2001 JH