REVISED	FHWA REGION	STATE	FEDERAL AID PROJECT	ROUTE	STATE PROJECT	SHEET NO.
06-26-07 02-05-08 6-5-09 10-23-09 12-11-09 01-14-10		VA		221	0221-080-108 RW-202, C-502	5

DESIGN FEATURES RELATING TO CONSTRUCTION OR TO REGULATION AND CONTROL OF TRAFFIC MAY BE SUBJECT TO CHANGE AS DEEMED NECESSARY BY THE DEPARTMENT

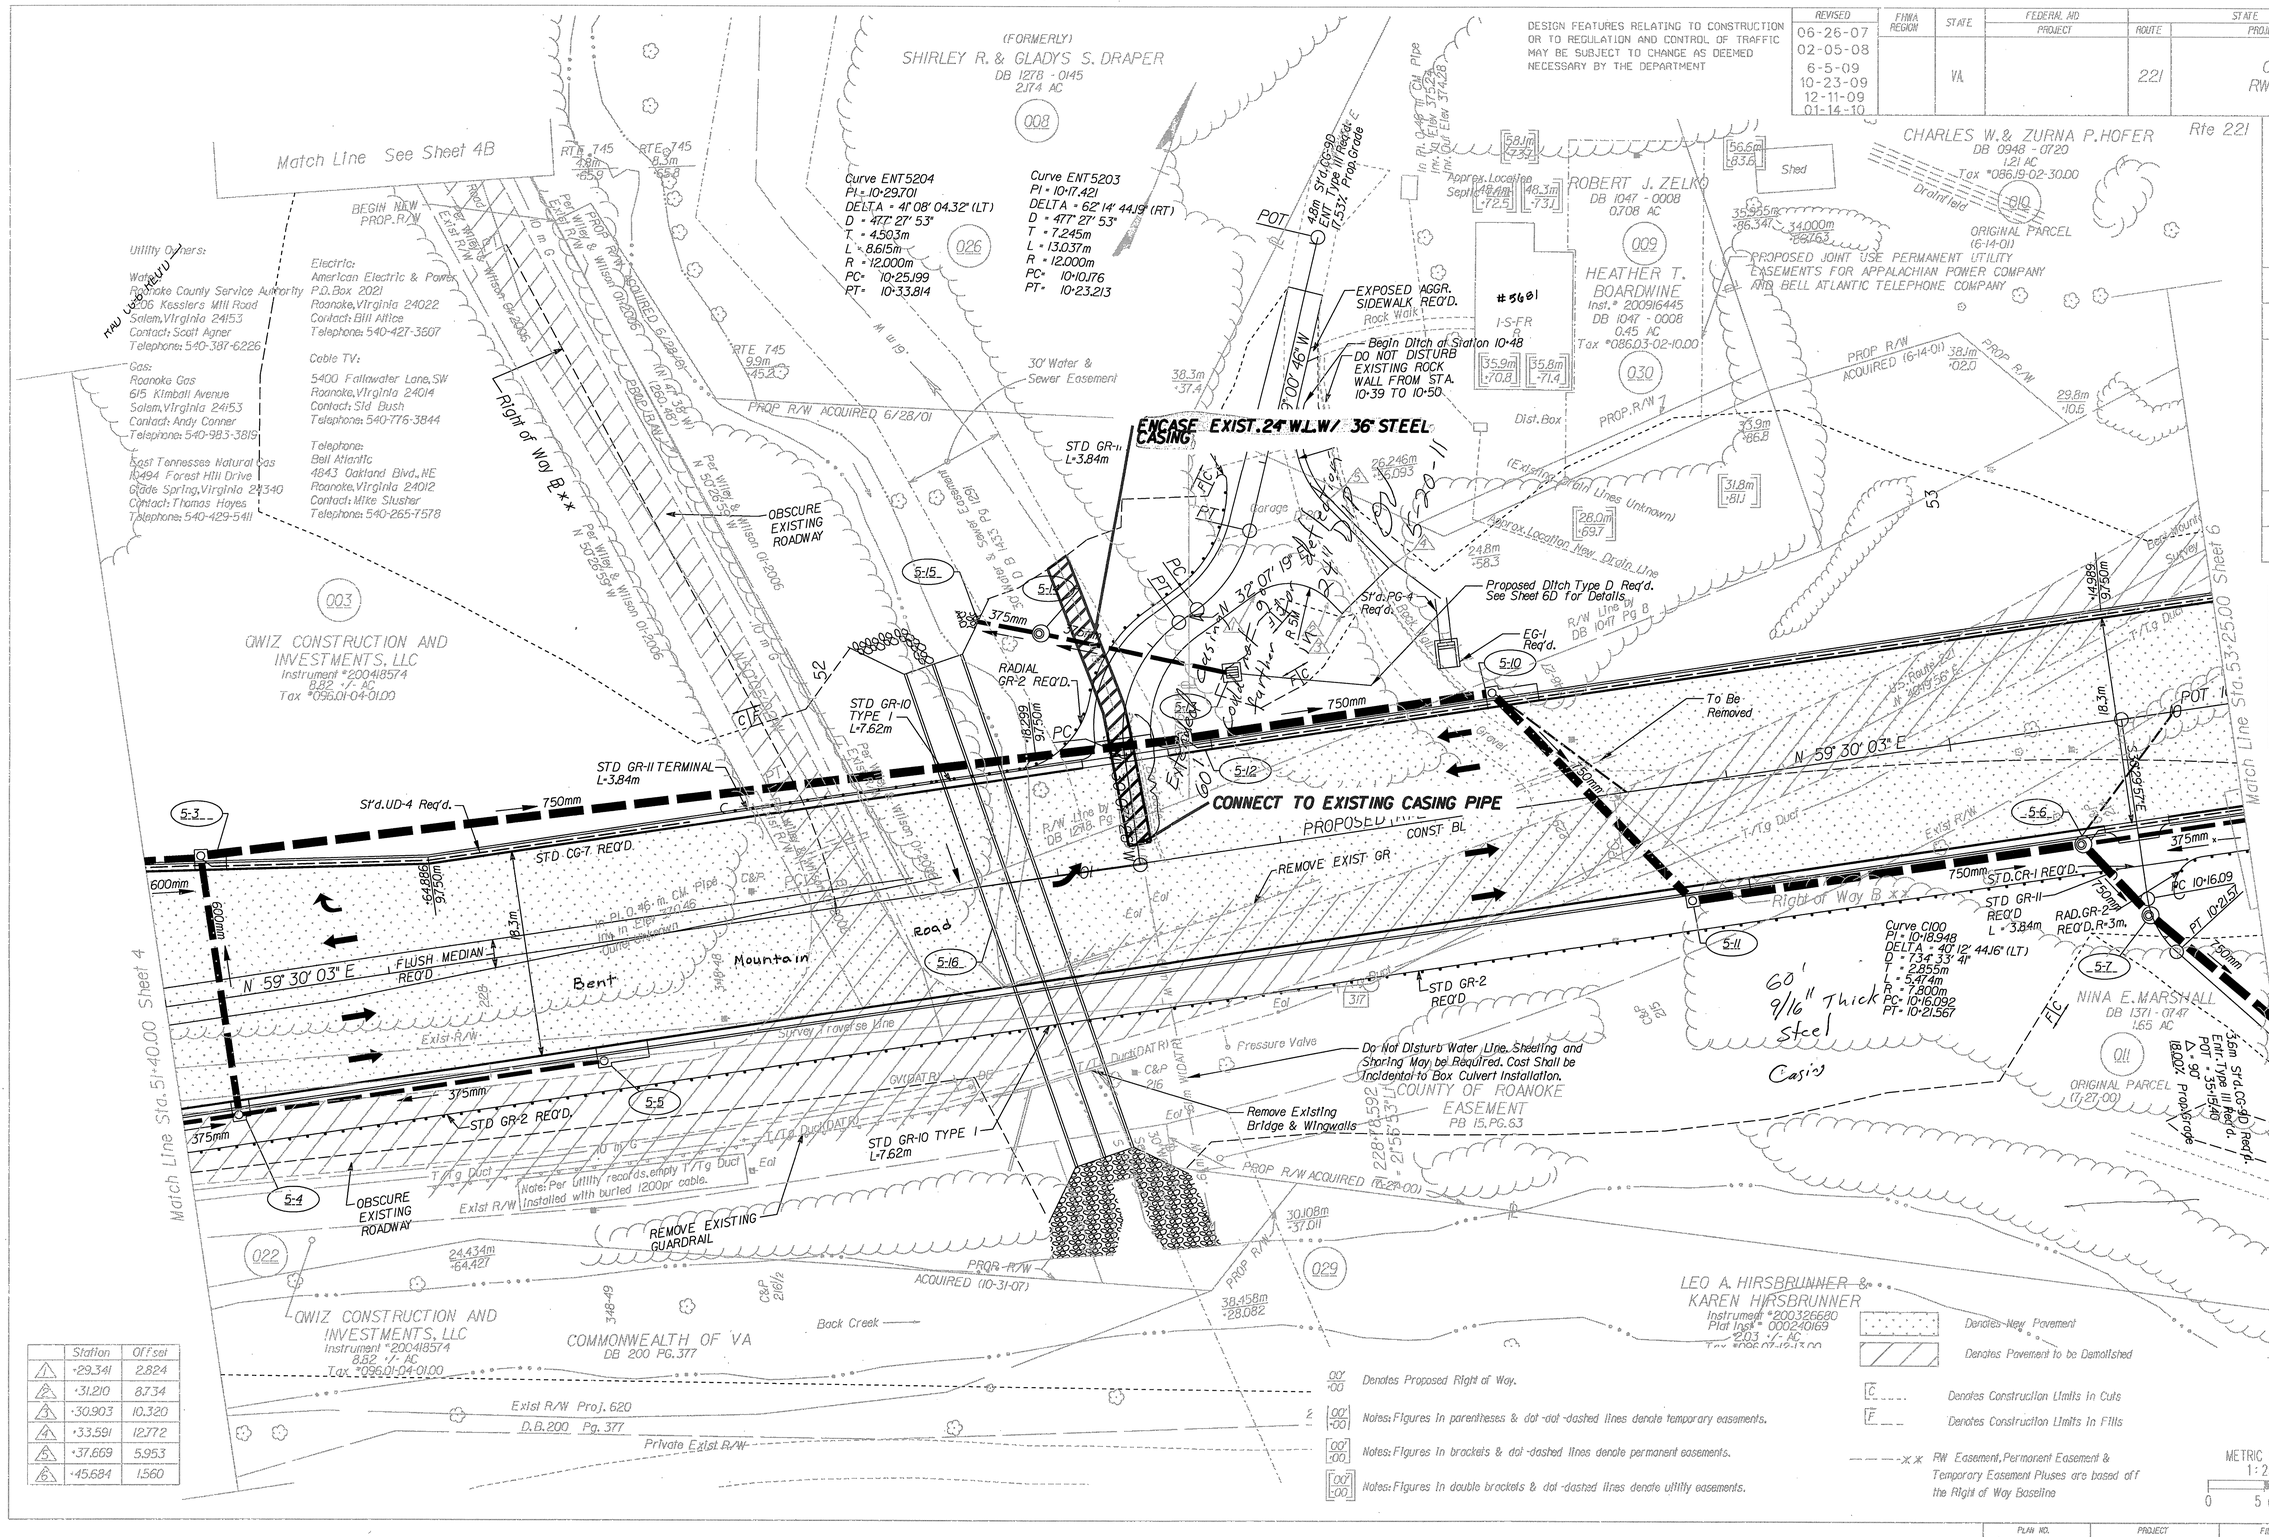

	Station	Offset
1	+29.341	2.824
2	+31.210	8.734
3	+30.903	10.320
4	+33.591	12.772
5	+37.669	5.953
6	+45.684	1.560

VDOT Location and Design
Richmond, Virginia
ROADWAY ENGINEER

AECOM USA, Inc.
Roanoke, Virginia
HYDRAULICS ENGINEER

REFERENCE BLOCK

Basin Details	2F(1)
Ditch Details	6D
Main Line Profile	5A
Entrance Profile	14
Entrance Typical	2C(1)
Drainage Desc	3B
E&S PLANS	5B & 5C

SURVEYED BY White & Wilson
PROJECT MANAGER C.E. Gamble 540-387-5561
DESIGN SUPERVISED BY Jason Williams, P.E. 804-786-9074
DESIGNED BY Phan Ong 804-786-4115
REVISED BY

PLAN NO.	PROJECT	FILE NO.	SHEET NO.
A	0221-080-108		5

...\Utilities\50006\sht 5 WVWA.dgn 2/16/2010 10:34:40 AM