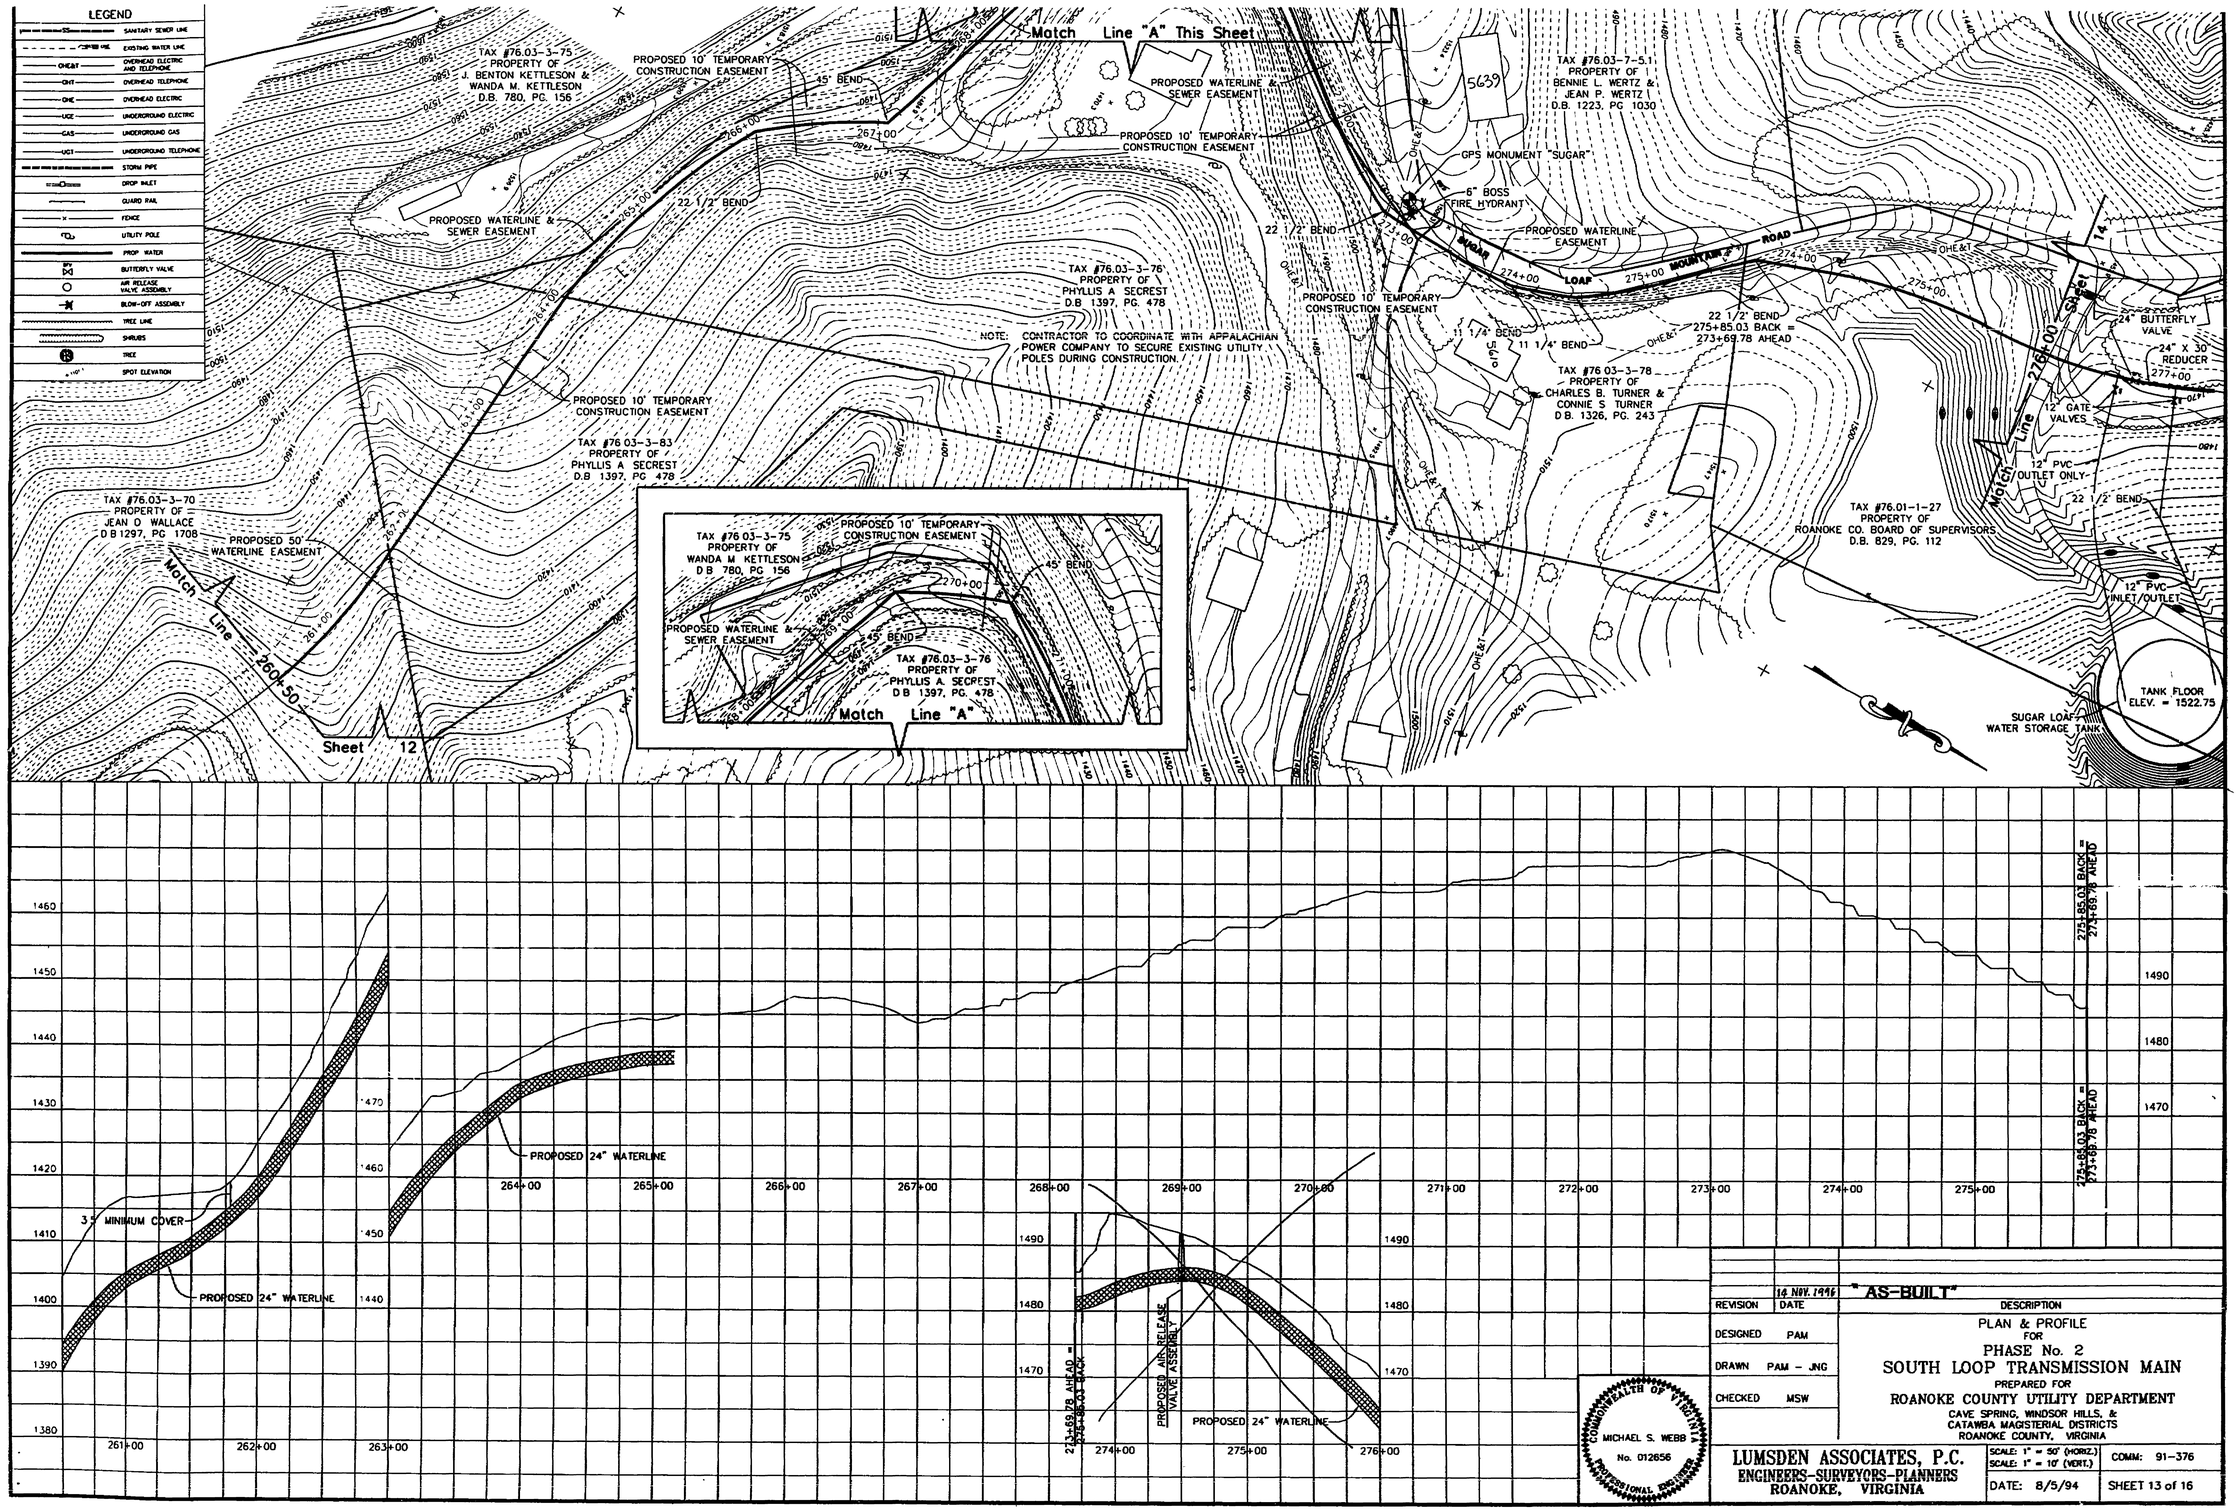

REVISION	DATE	DESCRIPTION
	16 NOV. 1996	"AS-BUILT"

DESIGNED PAM
DRAWN PAM - JNG
CHECKED MSW

PLAN & PROFILE
FOR
PHASE No. 2
SOUTH LOOP TRANSMISSION MAIN
PREPARED FOR
ROANOKE COUNTY UTILITY DEPARTMENT
CAVE SPRING, WINDSOR HILLS, & CATAWBA MAGISTERIAL DISTRICTS
ROANOKE COUNTY, VIRGINIA

LUMSDEN ASSOCIATES, P.C.
ENGINEERS-SURVEYORS-PLANNERS
ROANOKE, VIRGINIA

SCALE: 1" = 50' (HORIZ.)
SCALE: 1" = 10' (VERT.)
DATE: 8/5/94
COMM: 91-376
SHEET 13 of 16

WT-0482