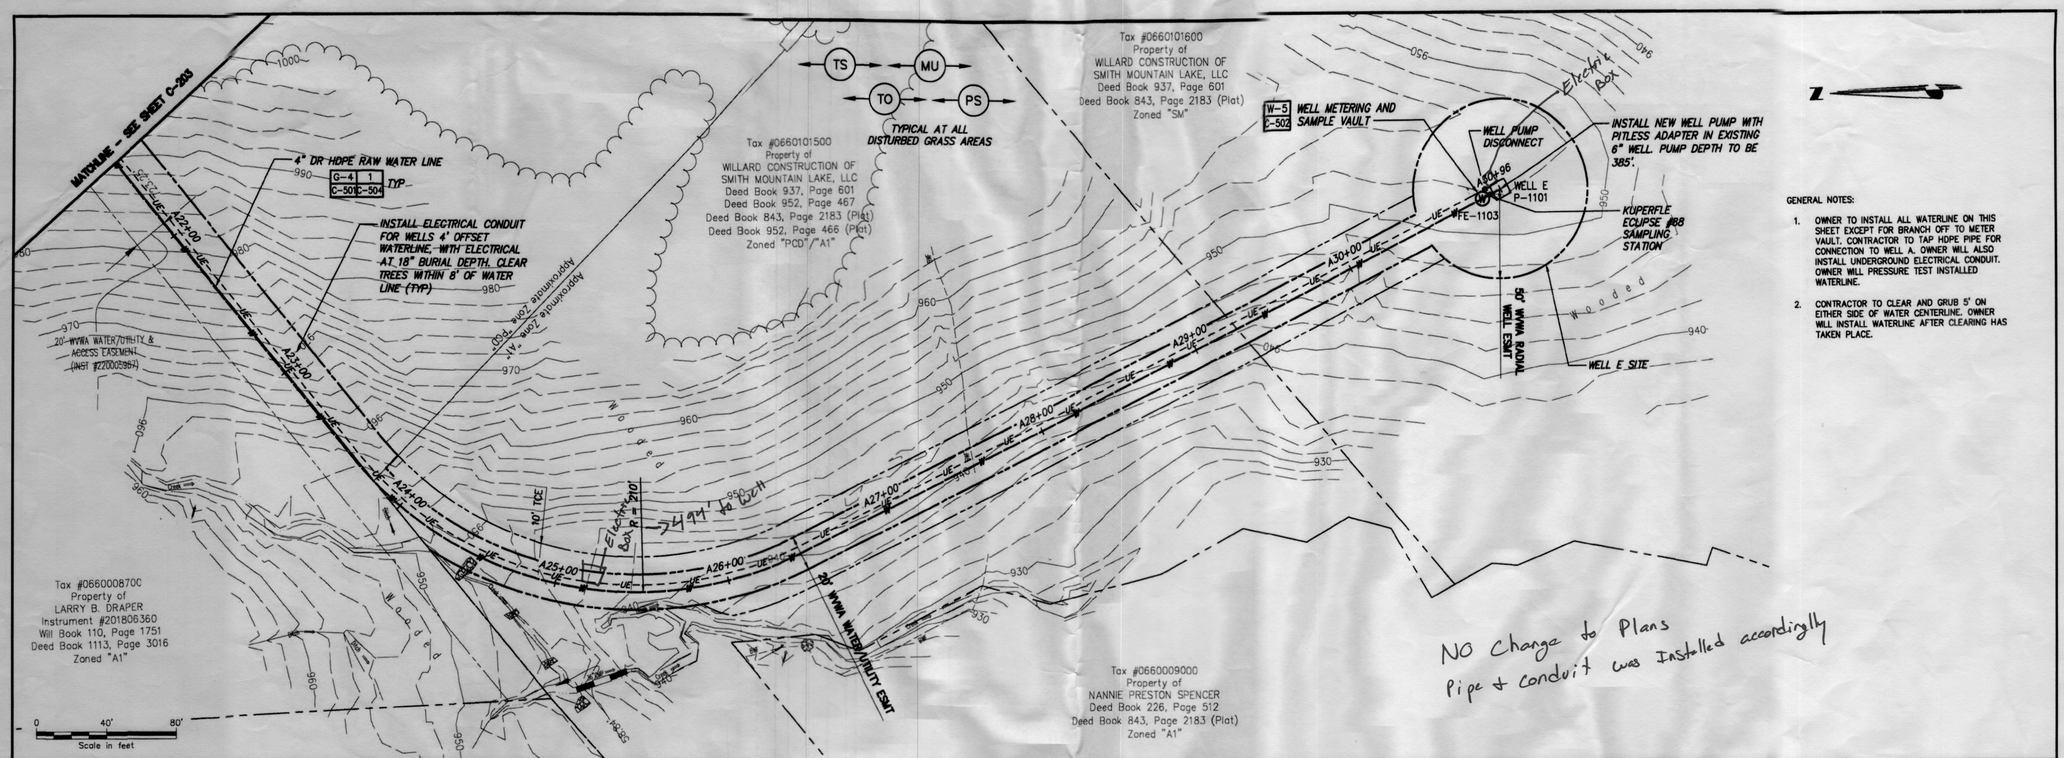

NO Change to Plans
Pipe & conduit was Installed accordingly

GENERAL NOTES:

1. OWNER TO INSTALL ALL WATERLINE ON THIS SHEET EXCEPT FOR BRANCH OFF TO METER VAULT. CONTRACTOR TO TAP HDPE PIPE FOR CONNECTION TO WELL A. OWNER WILL ALSO INSTALL UNDERGROUND ELECTRICAL CONDUIT. OWNER WILL PRESSURE TEST INSTALLED WATERLINE.
2. CONTRACTOR TO CLEAR AND GRUB 5' ON EITHER SIDE OF WATER CENTERLINE. OWNER WILL INSTALL WATERLINE AFTER CLEARING HAS TAKEN PLACE.

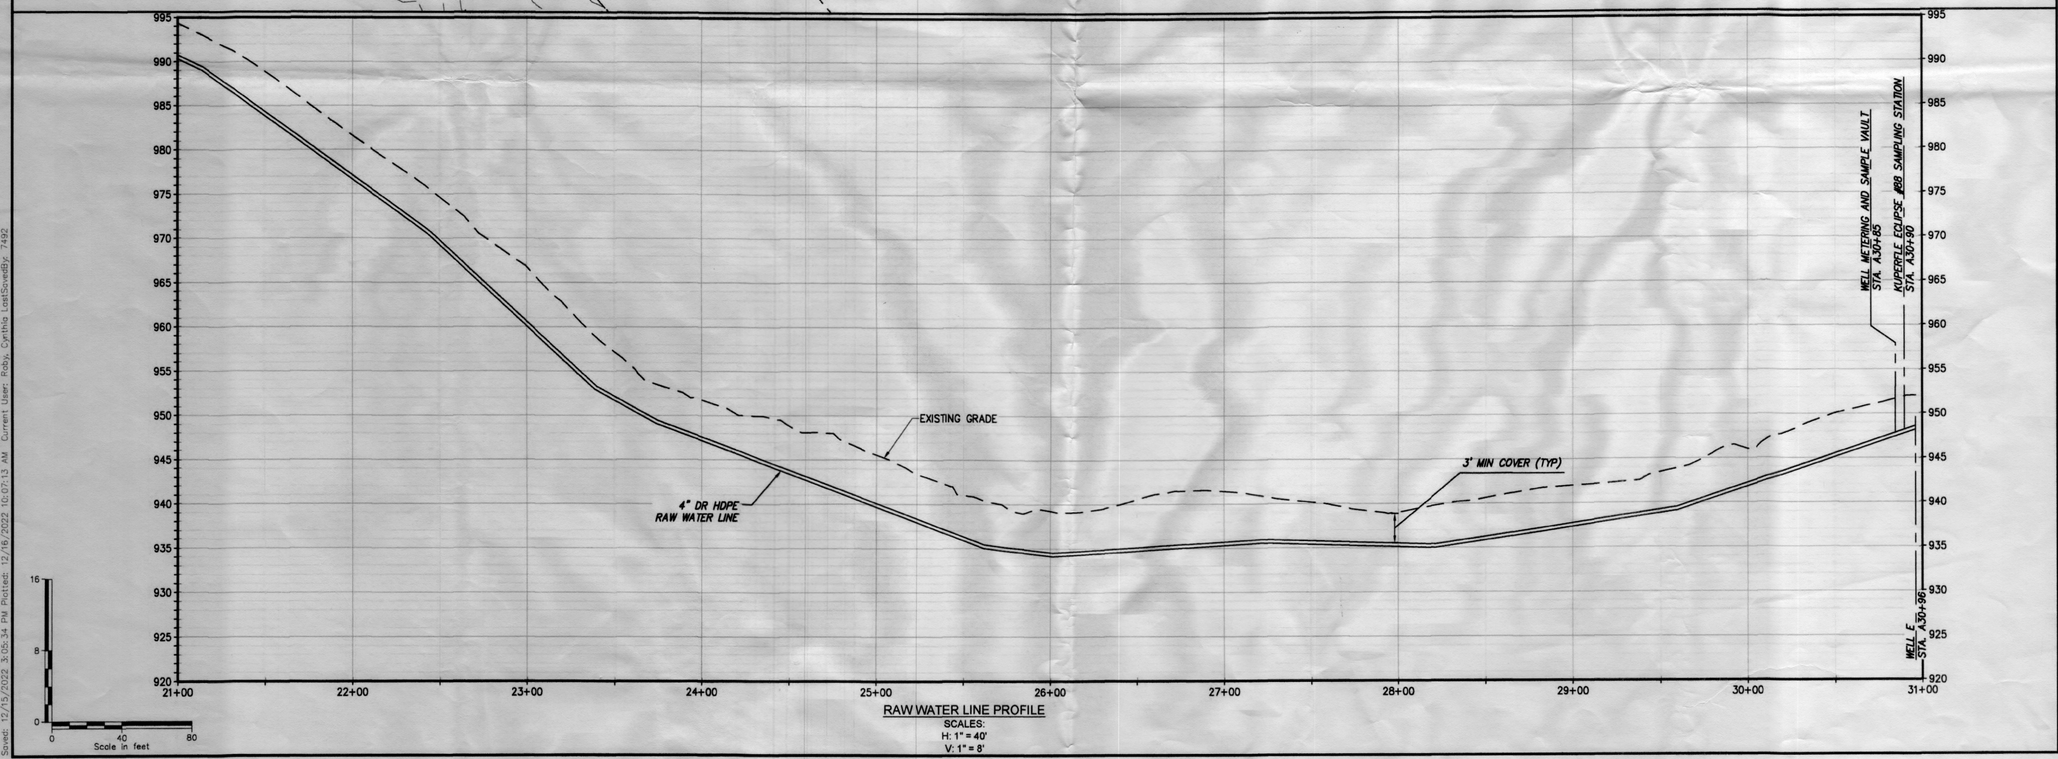

RAW WATER LINE PROFILE
SCALES:
H: 1" = 40'
V: 1" = 8'

File: V:\PROJECTS\ANY\K6\073612.000\09_DESIGN\DRAWINGS\01_SHEETS\PHASE 2 - PROCESS\73612_C-30X.DWG
Saved: 12/15/2022 3:05:34 PM Plotted: 12/16/2022 10:07:13 AM Current User: Roby, Cynthia LastSavedBy: 7492

Drawing Copyright © 2022

CHA
1341 Research Center Drive, Suite 2100
Blacksburg, VA 24060-5548
540.552.5548 · www.chacompanies.com

WESTERN VIRGINIA WATER AUTHORITY

WESTERN VIRGINIA WATER AUTHORITY

COMMONWEALTH OF VIRGINIA
ERIC T. ANDERSON
Lic. No. 040613
12/16/2022
PROFESSIONAL ENGINEER

IT IS A VIOLATION OF LAW FOR ANY PERSON, UNLESS THEY ARE ACTING UNDER THE DIRECTION OF A LICENSED PROFESSIONAL ENGINEER, ARCHITECT, LANDSCAPE ARCHITECT OR LAND SURVEYOR TO ALTER AN ITEM IN ANY WAY. IF AN ITEM BEARING THE STAMP OF A LICENSED PROFESSIONAL IS ALTERED, THE ALTERING ENGINEER, ARCHITECT, LANDSCAPE ARCHITECT OR LAND SURVEYOR SHALL STAMP THE DOCUMENT AND INCLUDE THE NOTATION "ALTERED BY" FOLLOWED BY THEIR SIGNATURE, THE DATE OF SUCH ALTERATION, AND A SPECIFIC DESCRIPTION OF THE ALTERATION.

SOUTHLAKE WATER SYSTEM

CONTRACT 1: WATER TREATMENT PLANT

CONTRACT 2: WATER MAIN

No.	Submittal / Revision	App'd.	By	Date
0	BID ISSUE	ETA	CDR	12/15/22

RAW WATER PLAN AND PROFILE

Designed By:	Drawn By:	Checked By:
CDR	AW	ETA
Issue Date: 12/15/22	Project No: 073612	Scale: AS NOTED

Drawing No.:

C-204