NOTE: FOR 12" MAIN – 180'± OF 24" O.D. SMOOTH STEEL PIPE.
CASING MIN. WALL THICKNESS 0.375" ASTM-A-139
GRADE B OR EQUIVALENT.

FOR 8" MAIN – 180'± OF 16" O.D. SMOOTH STEEL PIPE
CASING MIN. WALL THICKNESS 0.25" ASTM-A-139
GRADE B OR EQUIVALENT.

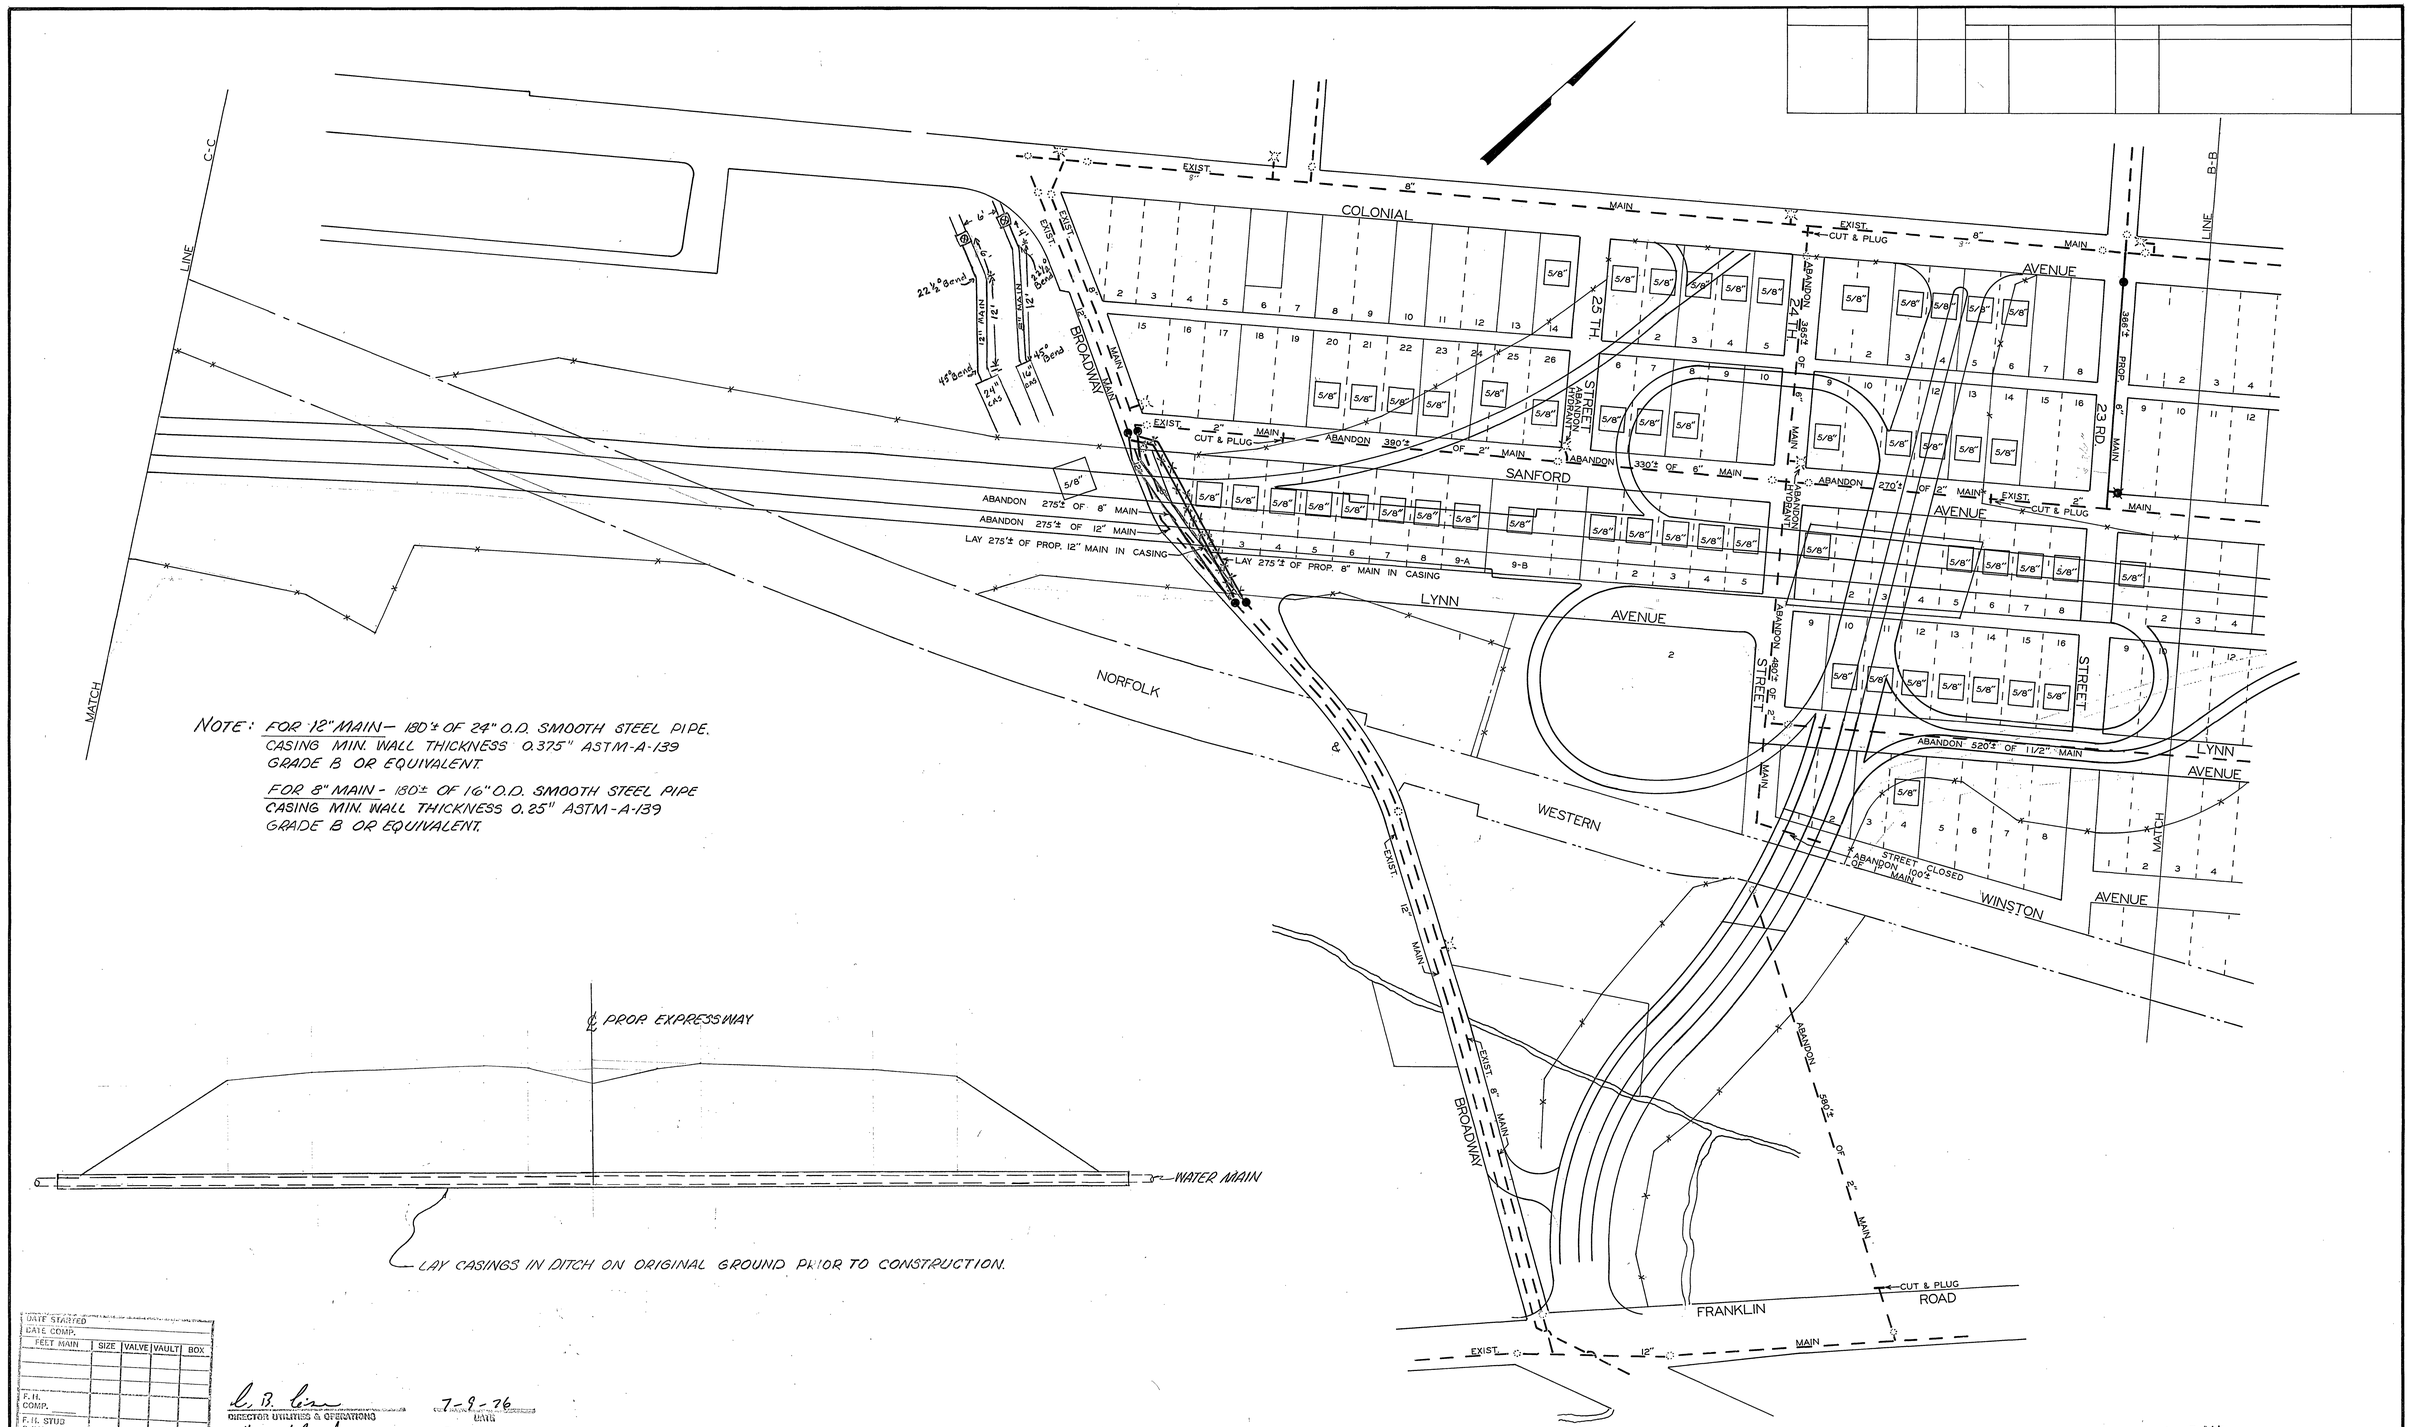

DATE STARTED				
DATE COMP.				
FEET MAIN	SIZE	VALVE	VAULT	BOX
F.H. COMP.				
F.H. STUD O-ALY				
SERV. INS. BY:				
MAIN INS. BY:				
NO. 3/4" SERV. INS.				
CITY OR CO.				
DEPT. INSP.				

L. B. Lion — DIRECTOR UTILITIES & OPERATIONS — DATE 7-8-76

Thomas F. Brock — CITY ENGINEER OF ROANOKE, VA. — DATE 7-8-76

DIRECTOR OF PUBLIC WORKS — DATE

AGENT FOR ROANOKE PLANNING COMM. — DATE

As-Built
REVISED: 2-13-76
7-8-76

Tax Maps 125, 127, 115, 116 SHEET 2

75-19