Suncrest Community Building D

Inspector: Brian Whitenack

As-built 11/18/16

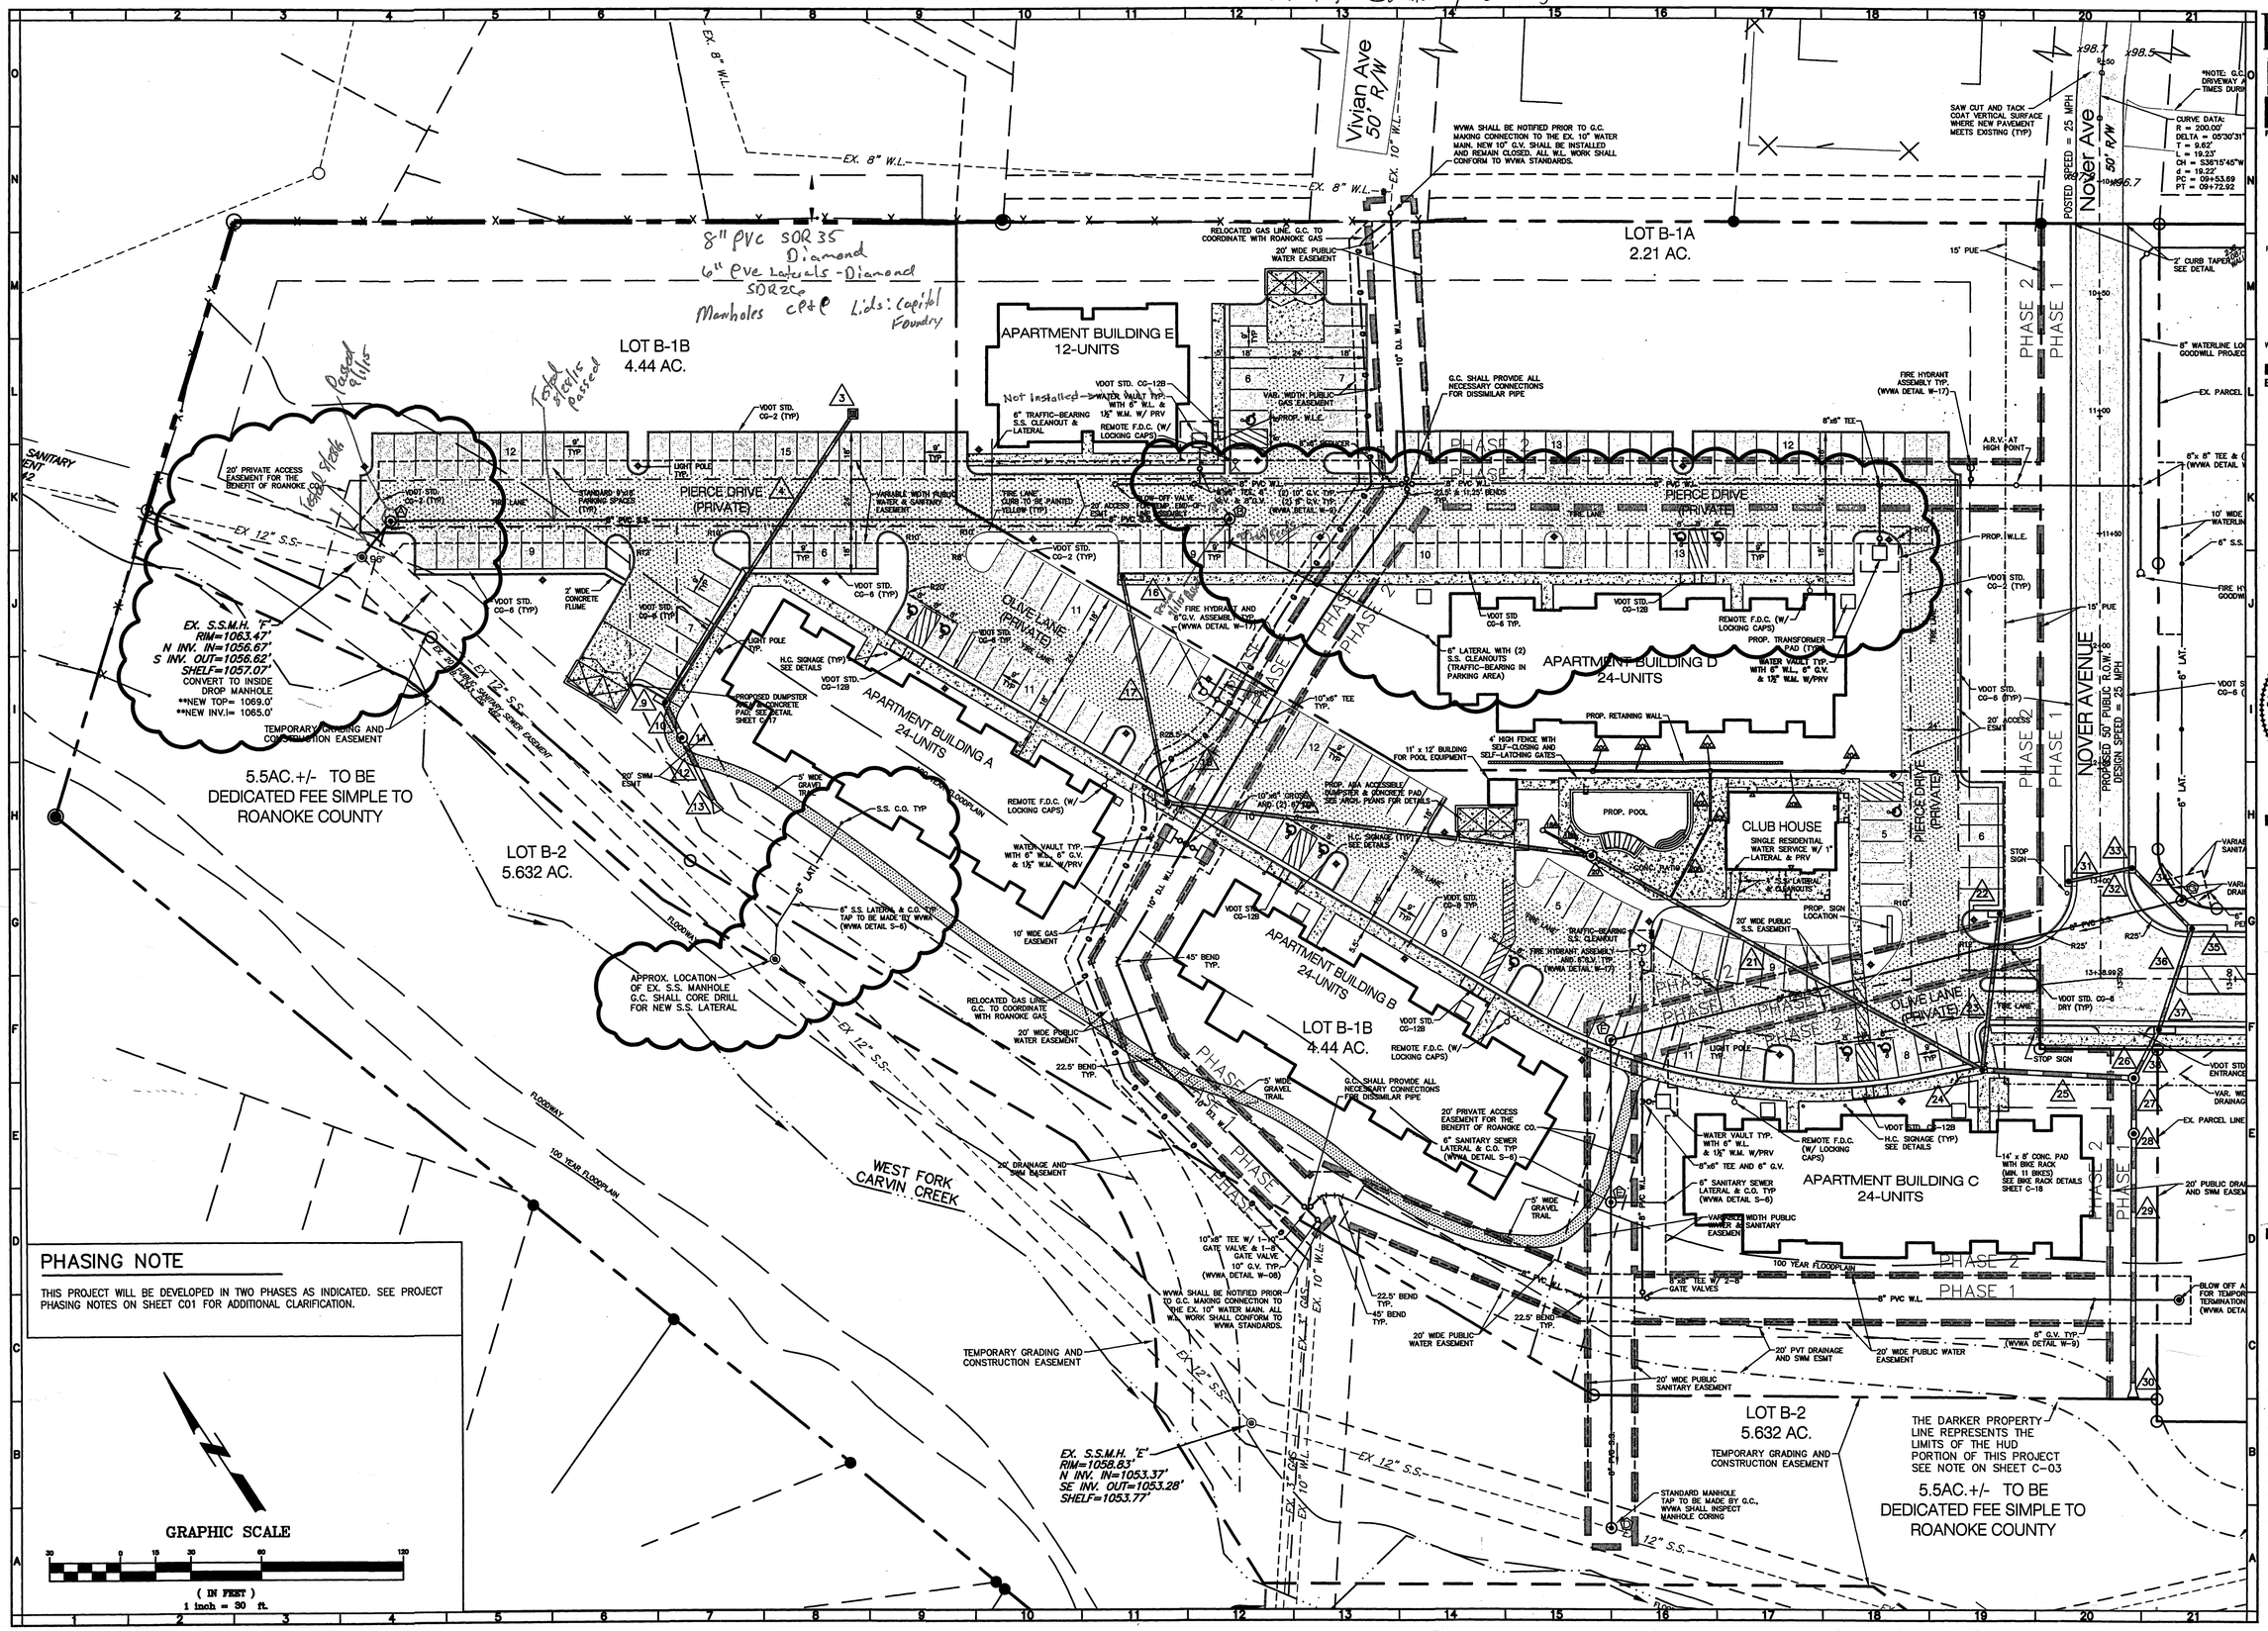

PHASING NOTE

THIS PROJECT WILL BE DEVELOPED IN TWO PHASES AS INDICATED. SEE PROJECT PHASING NOTES ON SHEET C01 FOR ADDITIONAL CLARIFICATION.

BALZER AND ASSOCIATES, INC.

REFLECTING TOMORROW

www.balzer.cc

New River Valley
Richmond
Roanoke
Shenandoah Valley

RESIDENTIAL LAND DEVELOPMENT ENGINEERING
SITE DEVELOPMENT ENGINEERING
LAND USE PLANNING & ZONING
LANDSCAPE ARCHITECTURE
LAND SURVEYING
ARCHITECTURE
STRUCTURAL ENGINEERING
TRANSPORTATION ENGINEERING
ENVIRONMENTAL & SOIL SCIENCE
WETLAND DELINEATIONS & STREAM EVALUATIONS

Balzer and Associates, Inc.
1208 Corporate Circle
Roanoke, VA 24018
540-772-9580
FAX 540-772-8050

Matt Cass
ROANOKE COUNTY APPROVED REVISION

COMMONWEALTH OF VIRGINIA
CHRISTOPHER P. BURNS
Lic. No.047338
6/5/15
PROFESSIONAL ENGINEER

SUNCREST COMMUNITY

LAYOUT & UTILITY PLAN

HOLLINS DISTRICT
ROANOKE COUNTY, VIRGINIA

DRAWN BY BTC
DESIGNED BY BTC
CHECKED BY CPB
DATE 05/24/2010
SCALE 1"=30'

REVISIONS:
08/13/2010
10/15/2010
12/10/2010
02/06/2012
10/18/2012
02/14/2013
02/27/2013
04/24/2013
08/30/2013 P.R. #2
12/15/2014 P.R. #4
06/05/2015 P.R. #5

SHEET NO.
C-05

JOB NO. R0900020.00