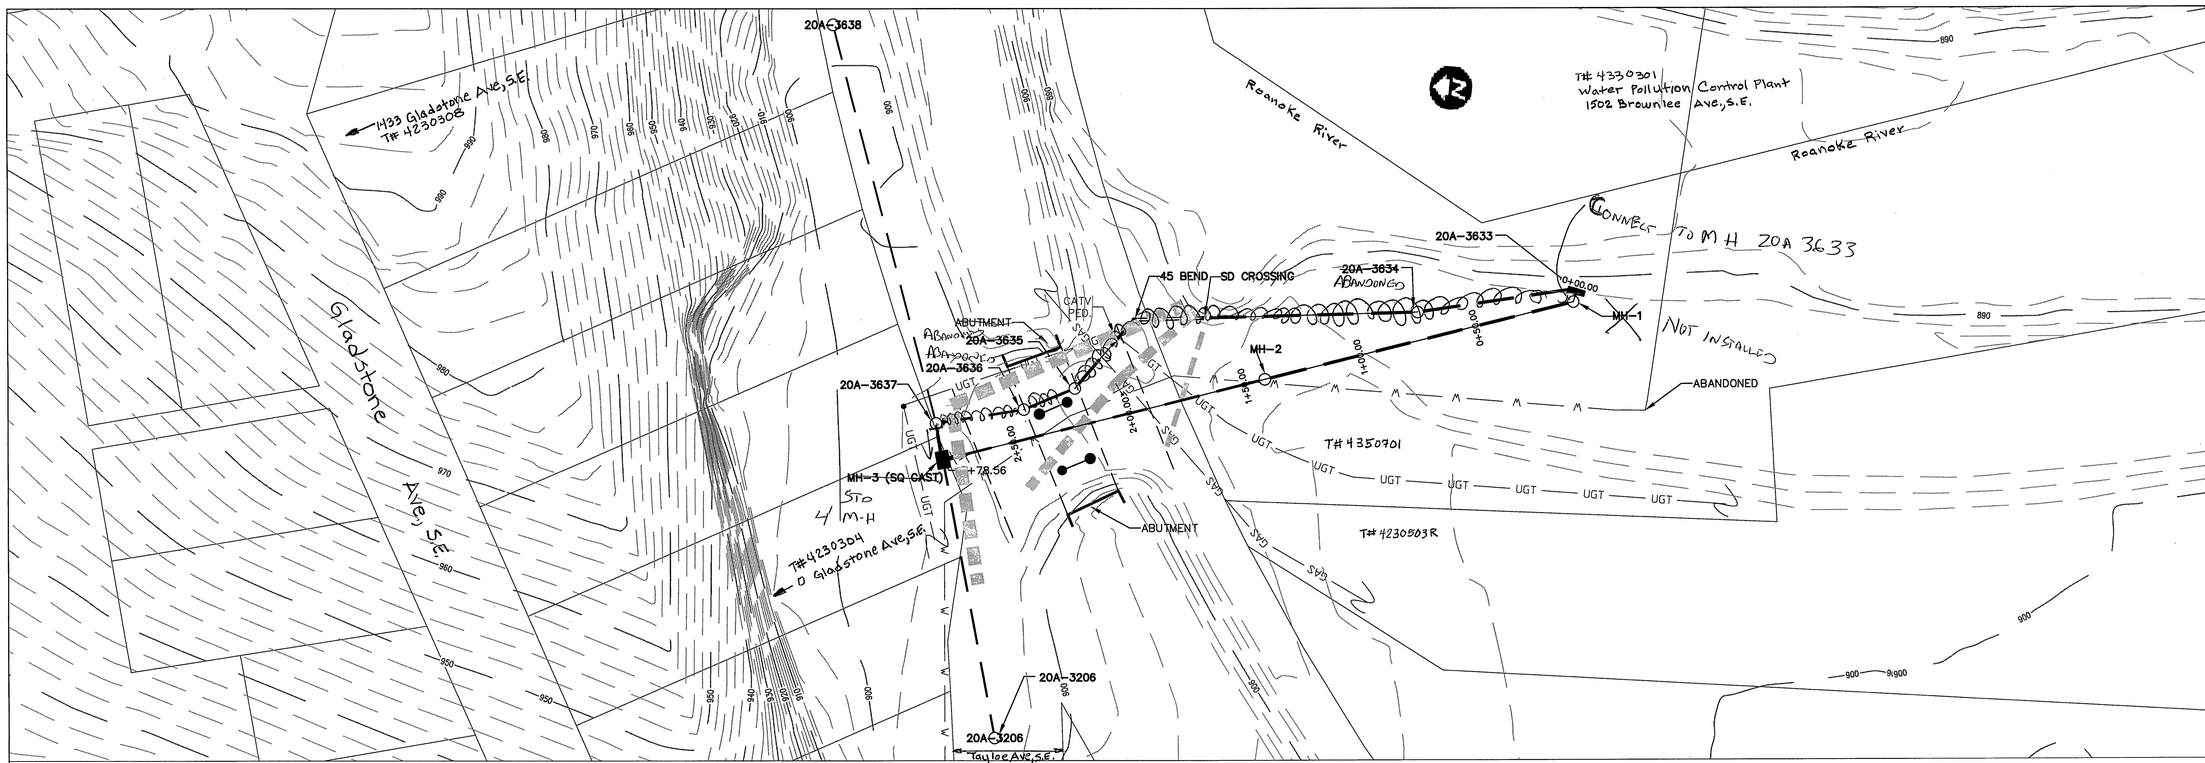

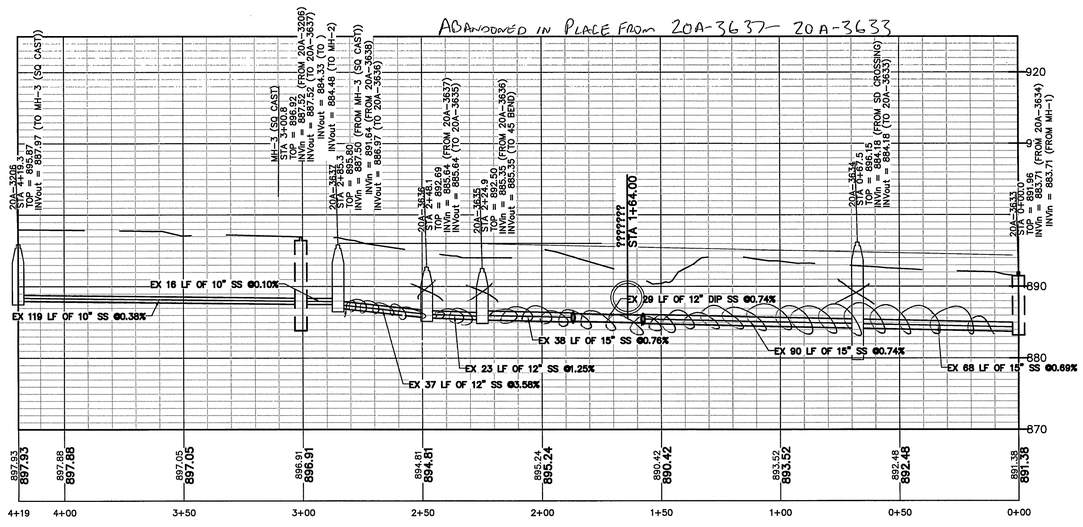

EXISTING SEWER PROFILE
SCALE
VERTICAL: 1" = 10'
HORIZONTAL: 1" = 30'

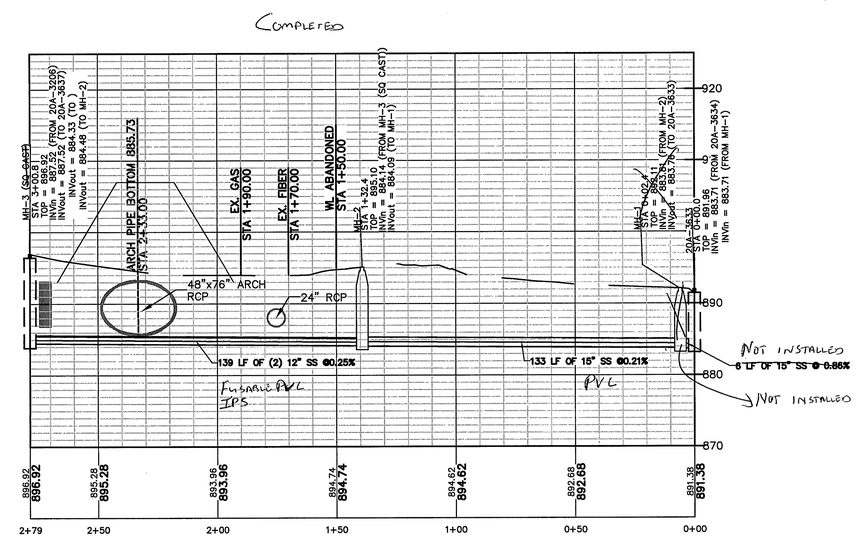

NEW SEWER
SCALE
VERTICAL: 1" = 10'
HORIZONTAL: 1" = 30'

WESTERN VIRGINIA WATER AUTHORITY
ENGINEERING SERVICES
601 S JEFFERSON ST, SUITE 300
ROANOKE, VA 24011
540-853-5641 or 540-853-5770

COMMONWEALTH OF VIRGINIA
J. GREGORY REED
Lic. No. 027721
PROFESSIONAL ENGINEER

TAYLOE SEWER

PLAN & PROFILE

Rev	Description	Date	By
	As-Built	10/2/2013	

Designed: AAS
Drawn: AAS
Checked:
Approved:
Date: 3-12-13
Project:

Sheet of