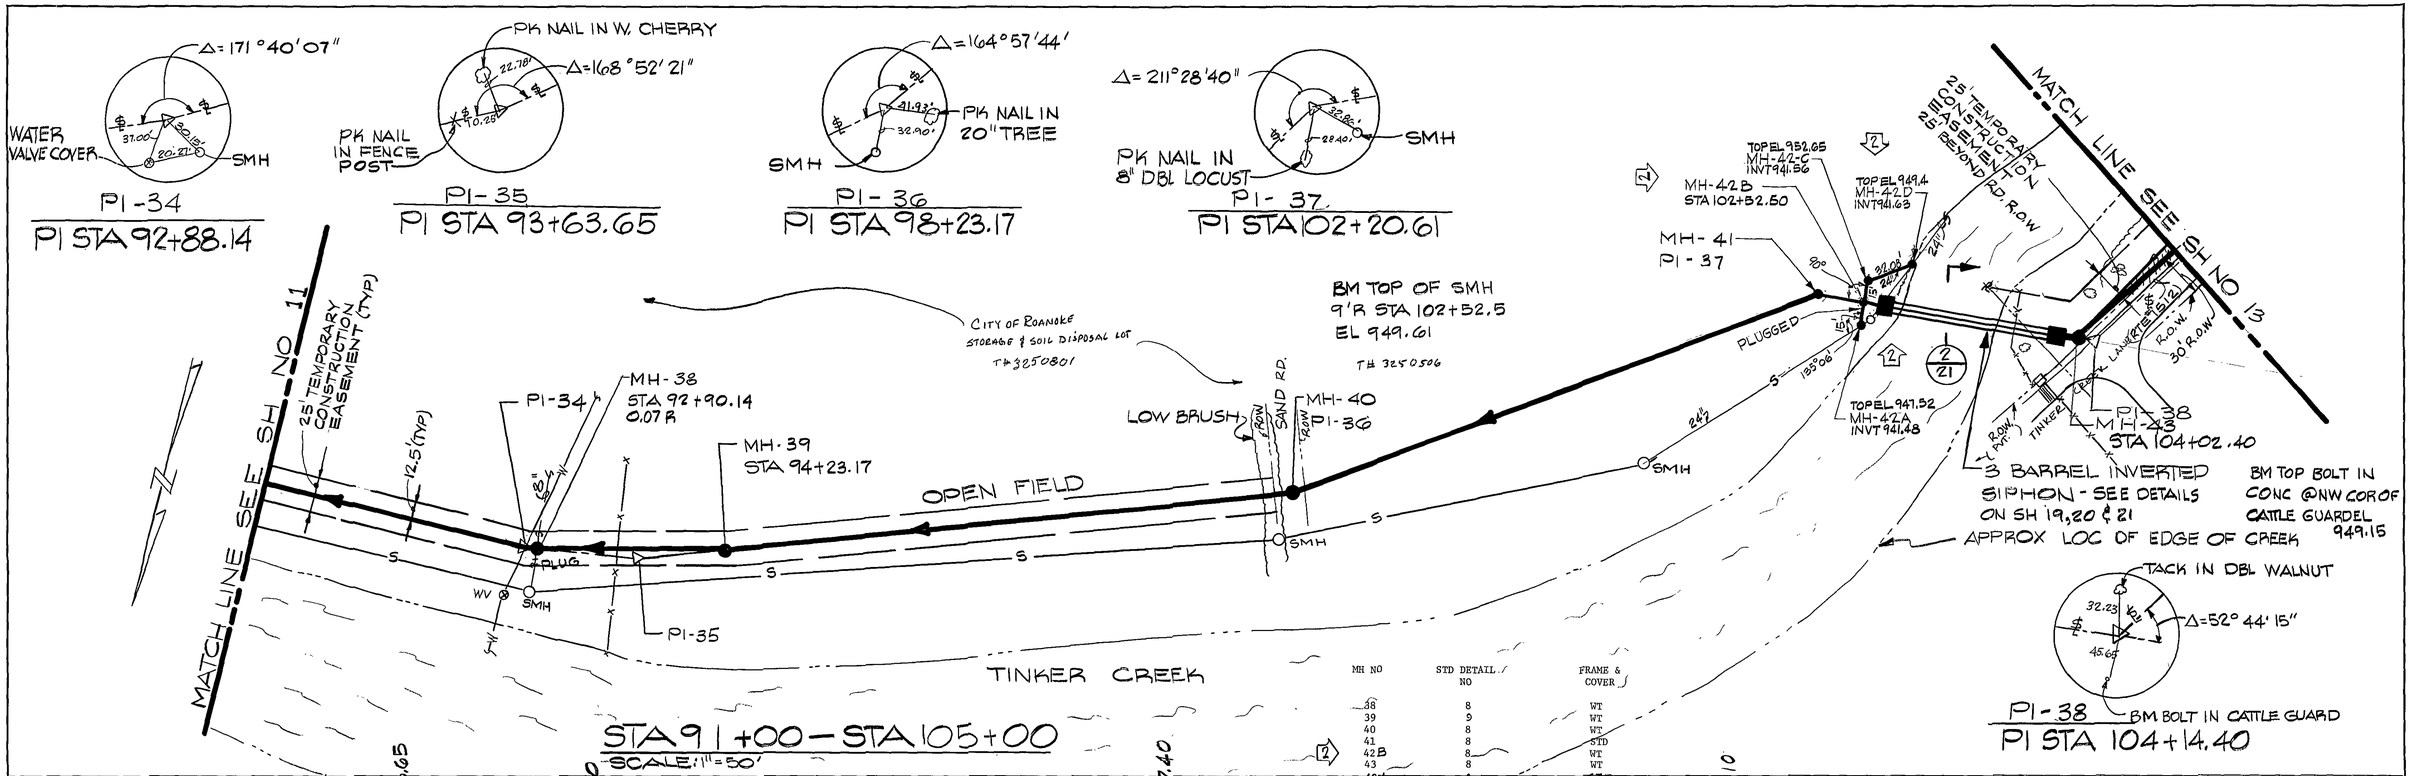

REVISION	DATE	DESCRIPTION	BY	APP
2	MAY 82	AS BUILT	DMC	SWH
1	9/23/01	REV LENGTHS	SWH	SWH

DESIGNED SWH
DRAWN MTA
CHECKED DMC
APPROVED JWC
SUBMITTED

TINKER CREEK SANITARY SEWER INTERCEPTOR

91+00—STA 105+00

CITY OF ROANOKE, VIRGINIA

Mattern and Craig
CONSULTING ENGINEERS
ROANOKE, VIRGINIA

SCALE: AS NOTED | COMM. NO. 347
DATE: OCT 1980 | SHEET 12

PLAN — SURVEYED, PLOTTED, ALIGNMENT CHECKED, RI. OF WAY CHECKED. NOTE BOOK No.

PROFILE — SURVEYED, PLOTTED, GRADES CHECKED, R. W. NOTED, STRUCTURE NOTATIONS CHECKED. NOTE BOOK No.

5773