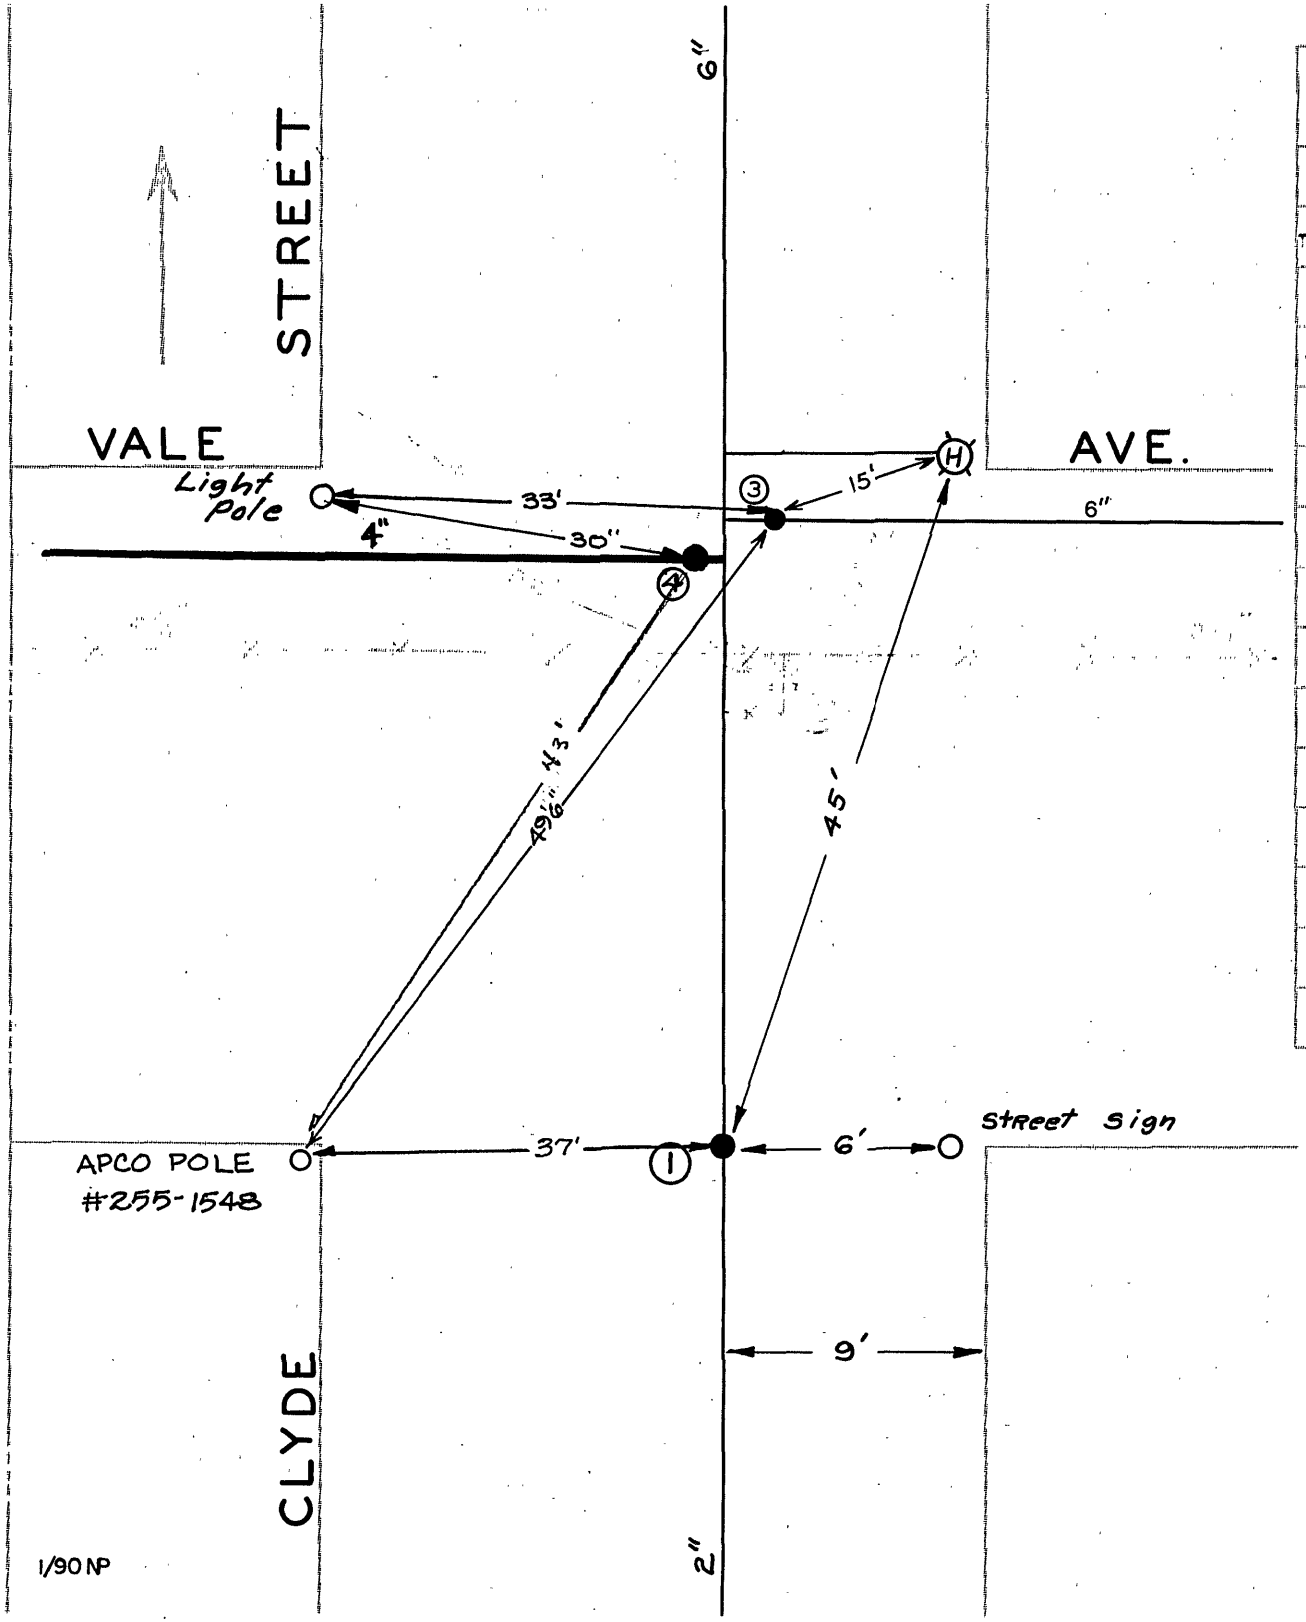

DATE	NO.	SIZE	MAKE	OPEN	TURNS
'59	1	2"	DARLING	R	
~~'59~~	~~2~~	~~3/4"~~	~~MISC.~~	~~L~~ ABANDONED	
71	3	6"	DARLING	R	
82	4	4"	MUELLER	R	
	1	0	SPL		
	~~2~~	~~25'S~~	~~NPL~~	ABANDONED	
	4	11'W	EPL		

CITY OF ROANOKE—WATER DEP'T

VALVE DIAGRAM

CLYDE STREET &
VALE AVE. N. E.

SEC. MAP 332

DATE PAGE NO.

1/90 NP