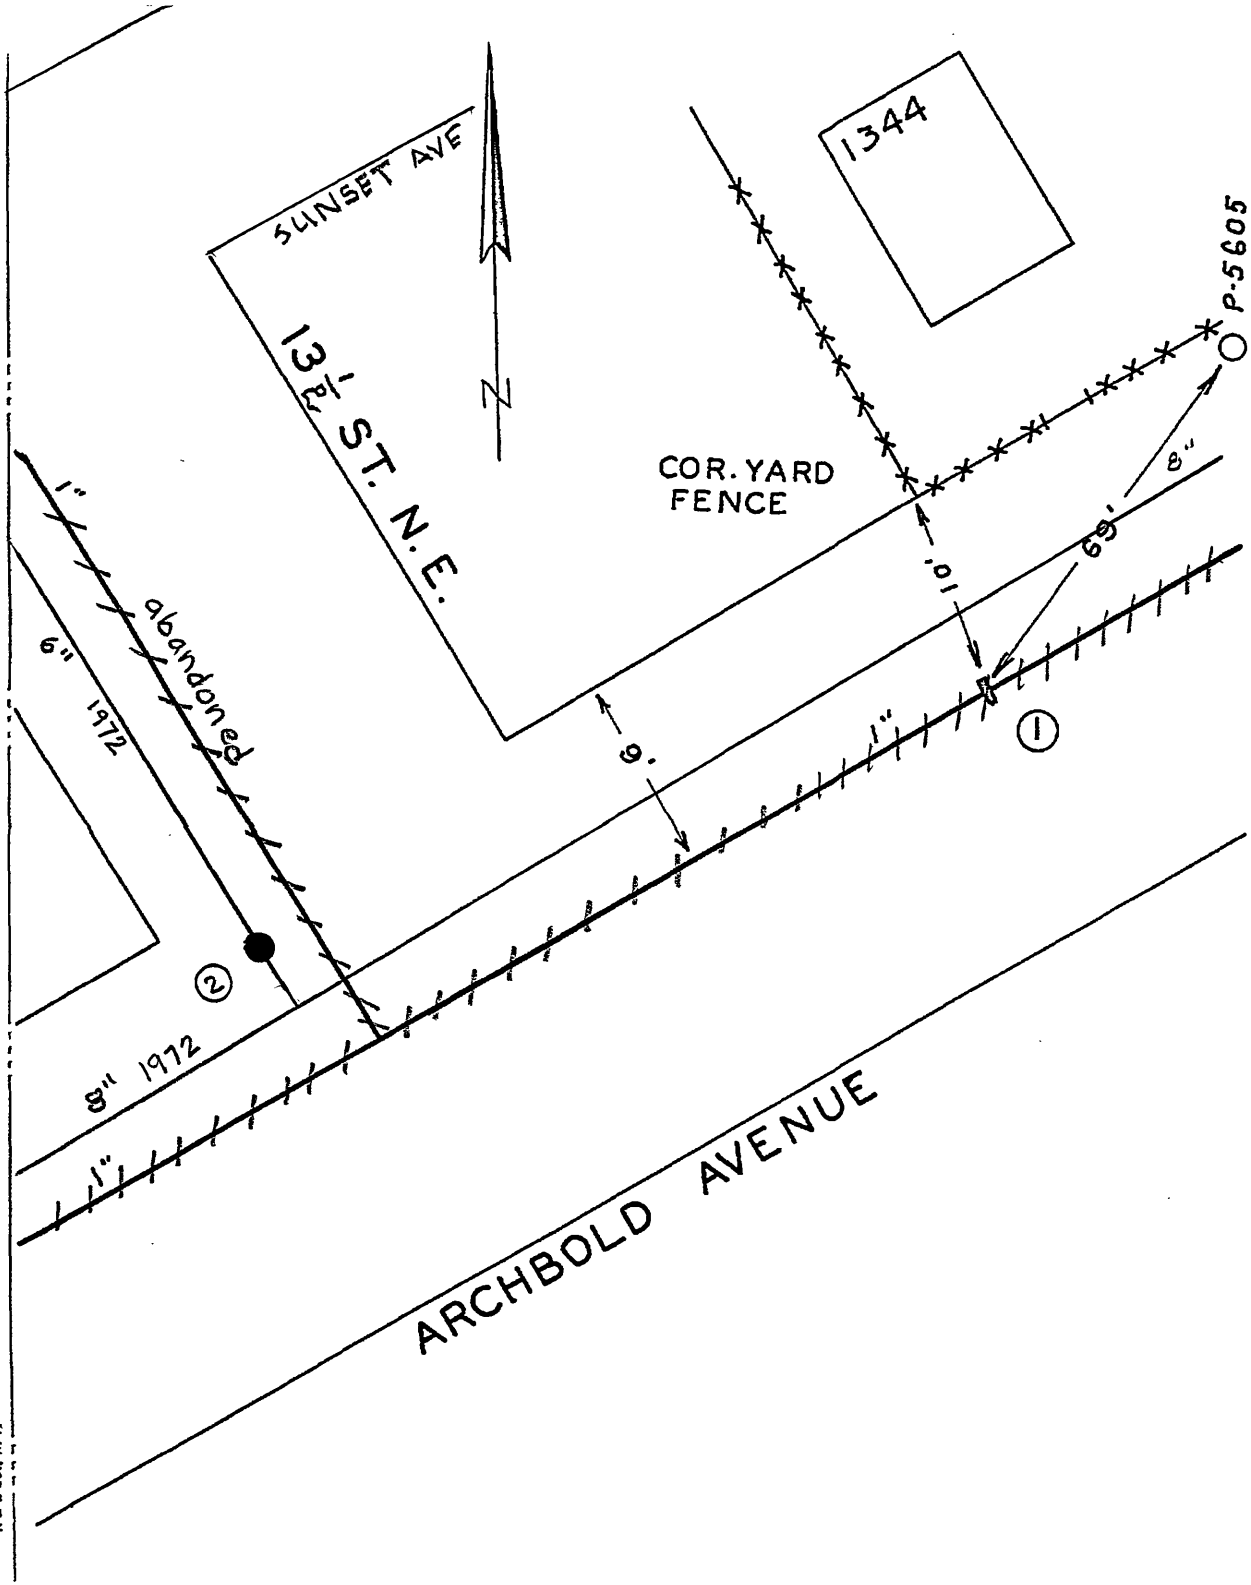

DATE	NO.	SIZE	MAKE	OPEN	TURNS
1951 ~~V.R.~~	~~1~~	~~1"~~	abandoned		
1972	2	6"			
	1	103'-E EPL-13½ ST.			

CITY OF ROANOKE—WATER DEPT. VALVE DIAGRAM
ARCHBOLD AVE. 100' EAST
OF 13½ ST. NE.
SEC. MAP 322
DATE PAGE NO.

"IMPERIAL" TRACING CLOTH K & E CO., N. Y.