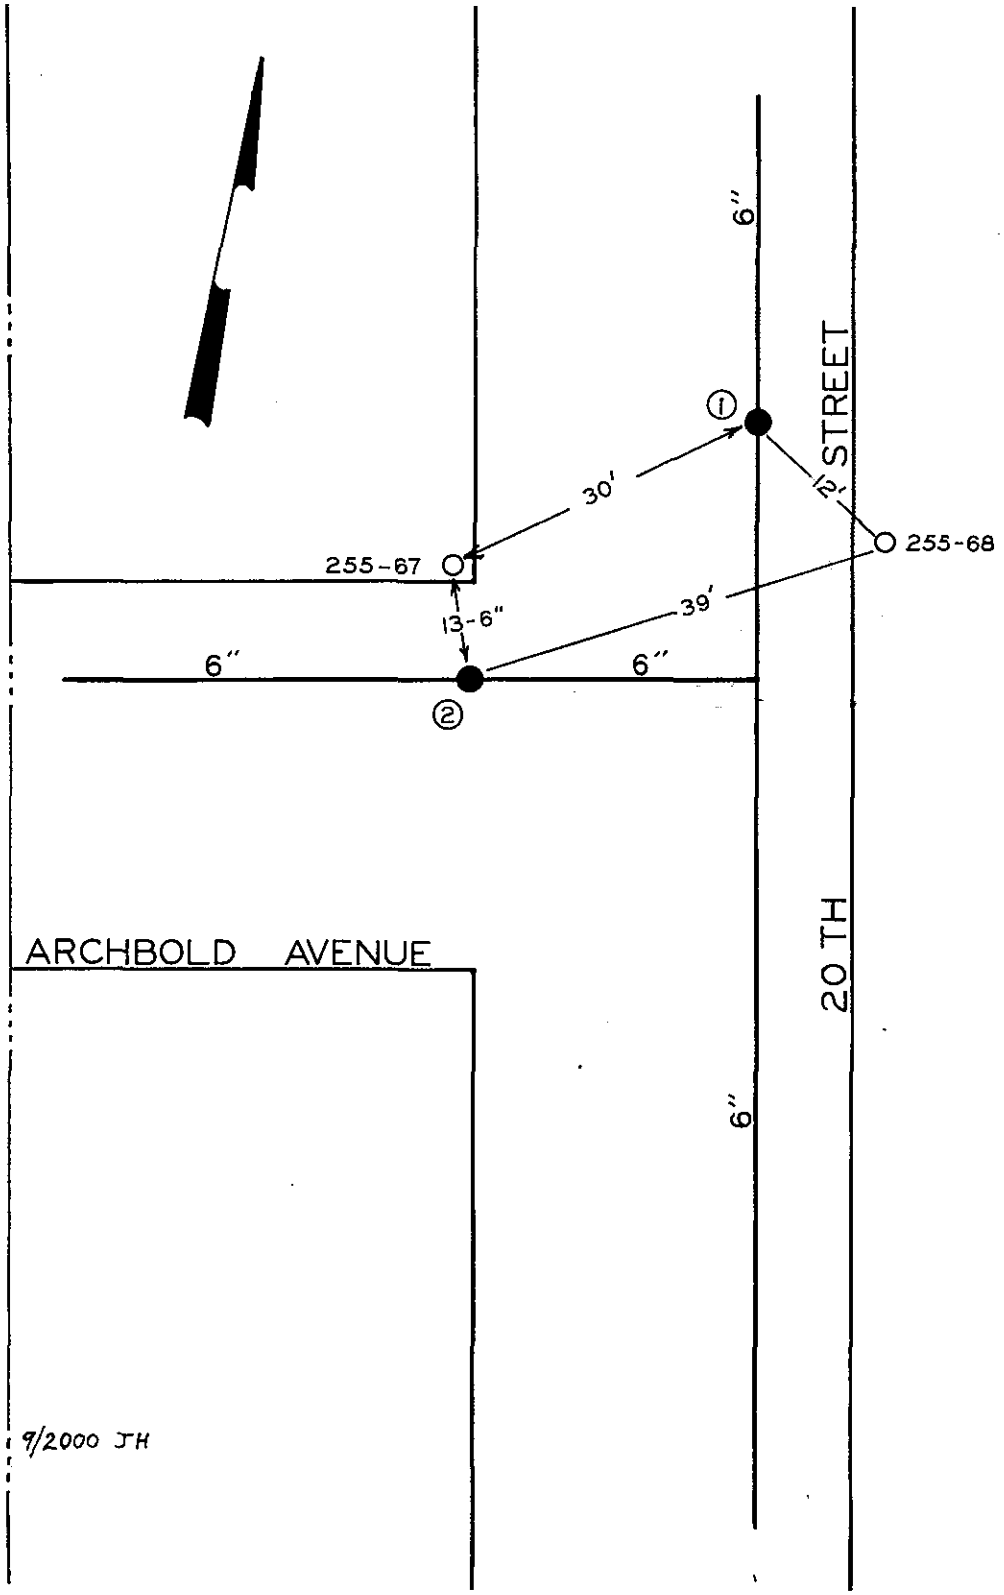

DATE	NO.	SIZE	MAKE	OPEN	TURNS
1968	1	6"	MUELLER	R	
1968	2	6"	MUELLER	L	

CITY OF ROANOKE—WATER DEPT.

VALVE DIAGRAM

ARCHBOLD AVE. &

20 TH STREET

SEC. MAP 322, 334 N.E.

DATE PAGE NO.