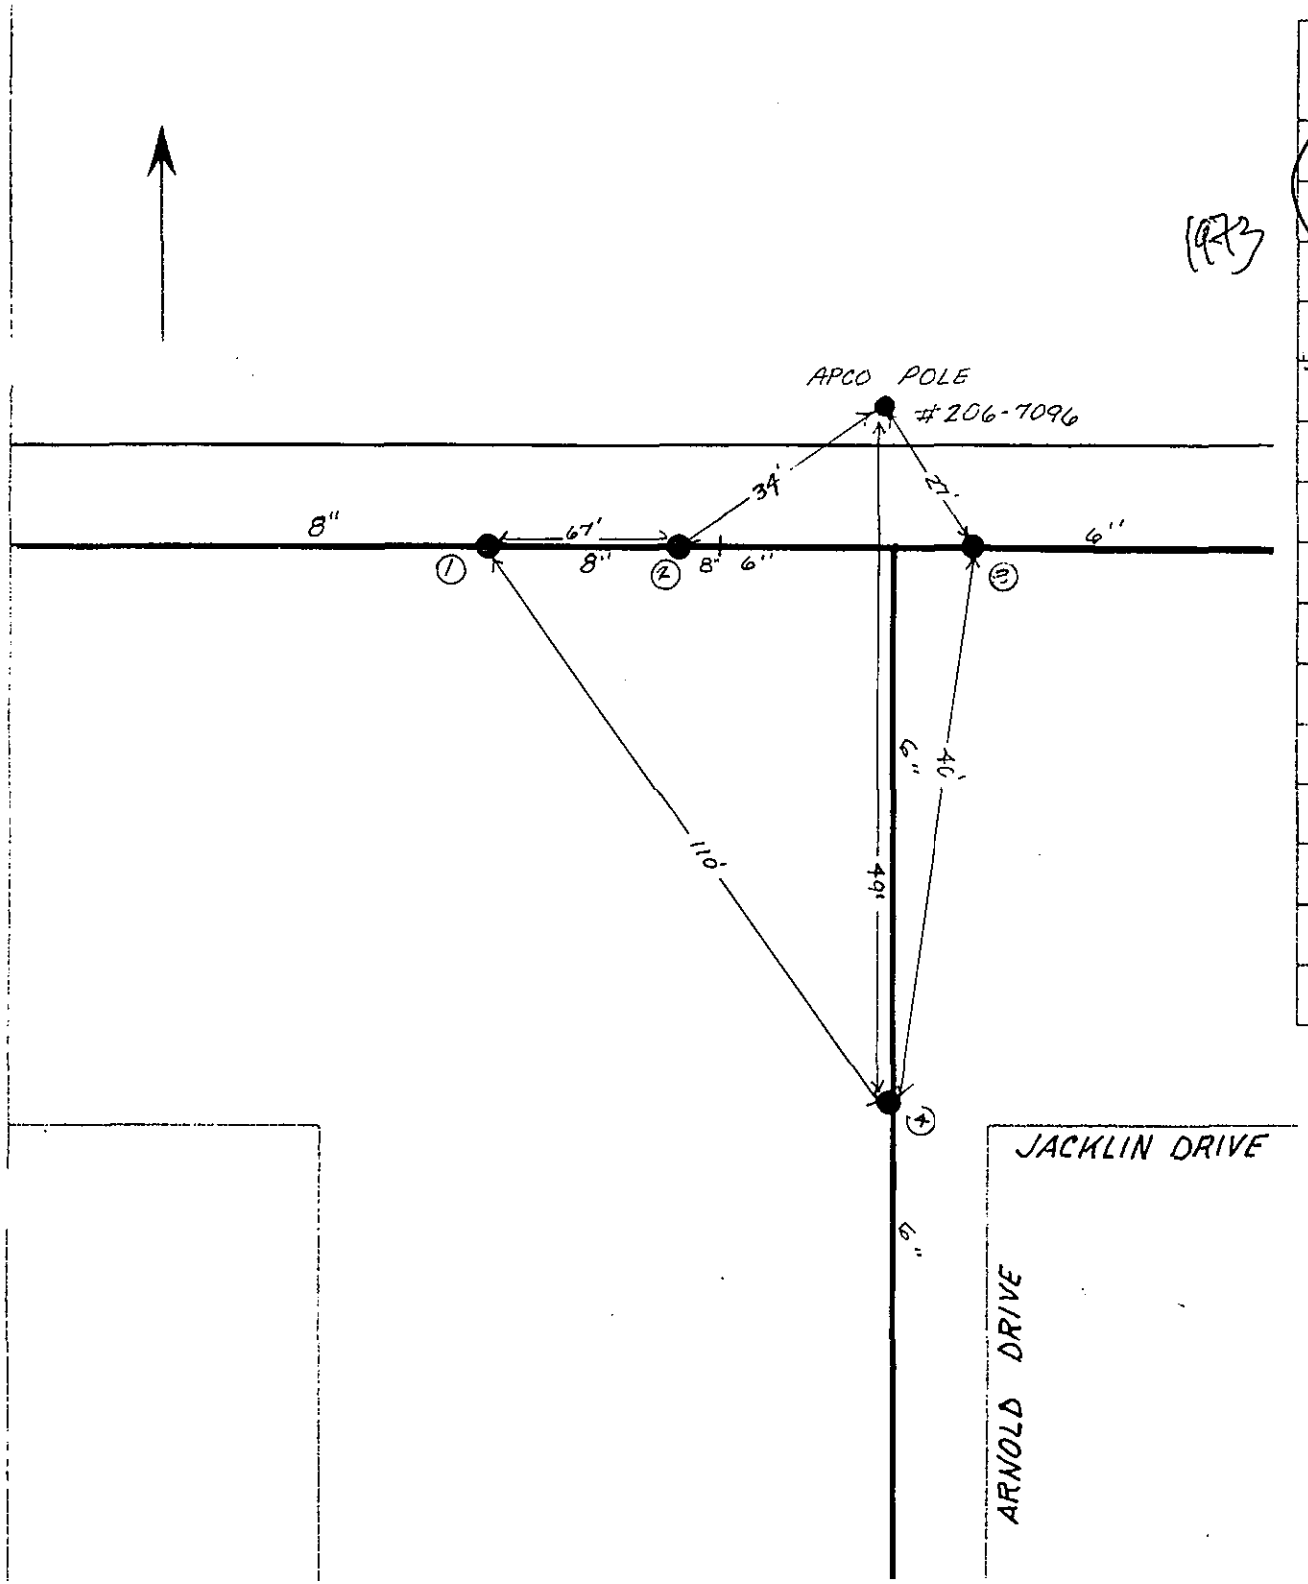

DATE	NO.	SIZE	MAKE	OPEN	TURNS
M.N 1980	1	8'			
	2	8"			
	3	6"			
	4	6"			

1973

M.N. MONTEREY NOV. WATER SYSTEM

CITY OF ROANOKE—WATER DEP'T

VALVE DIAGRAM

ARNOLD DRIVE AND

JACKLIN DRIVE N.E.

North Intersection

SEC. MAP 737

DATE JULY 3, 1980 PAGE NO