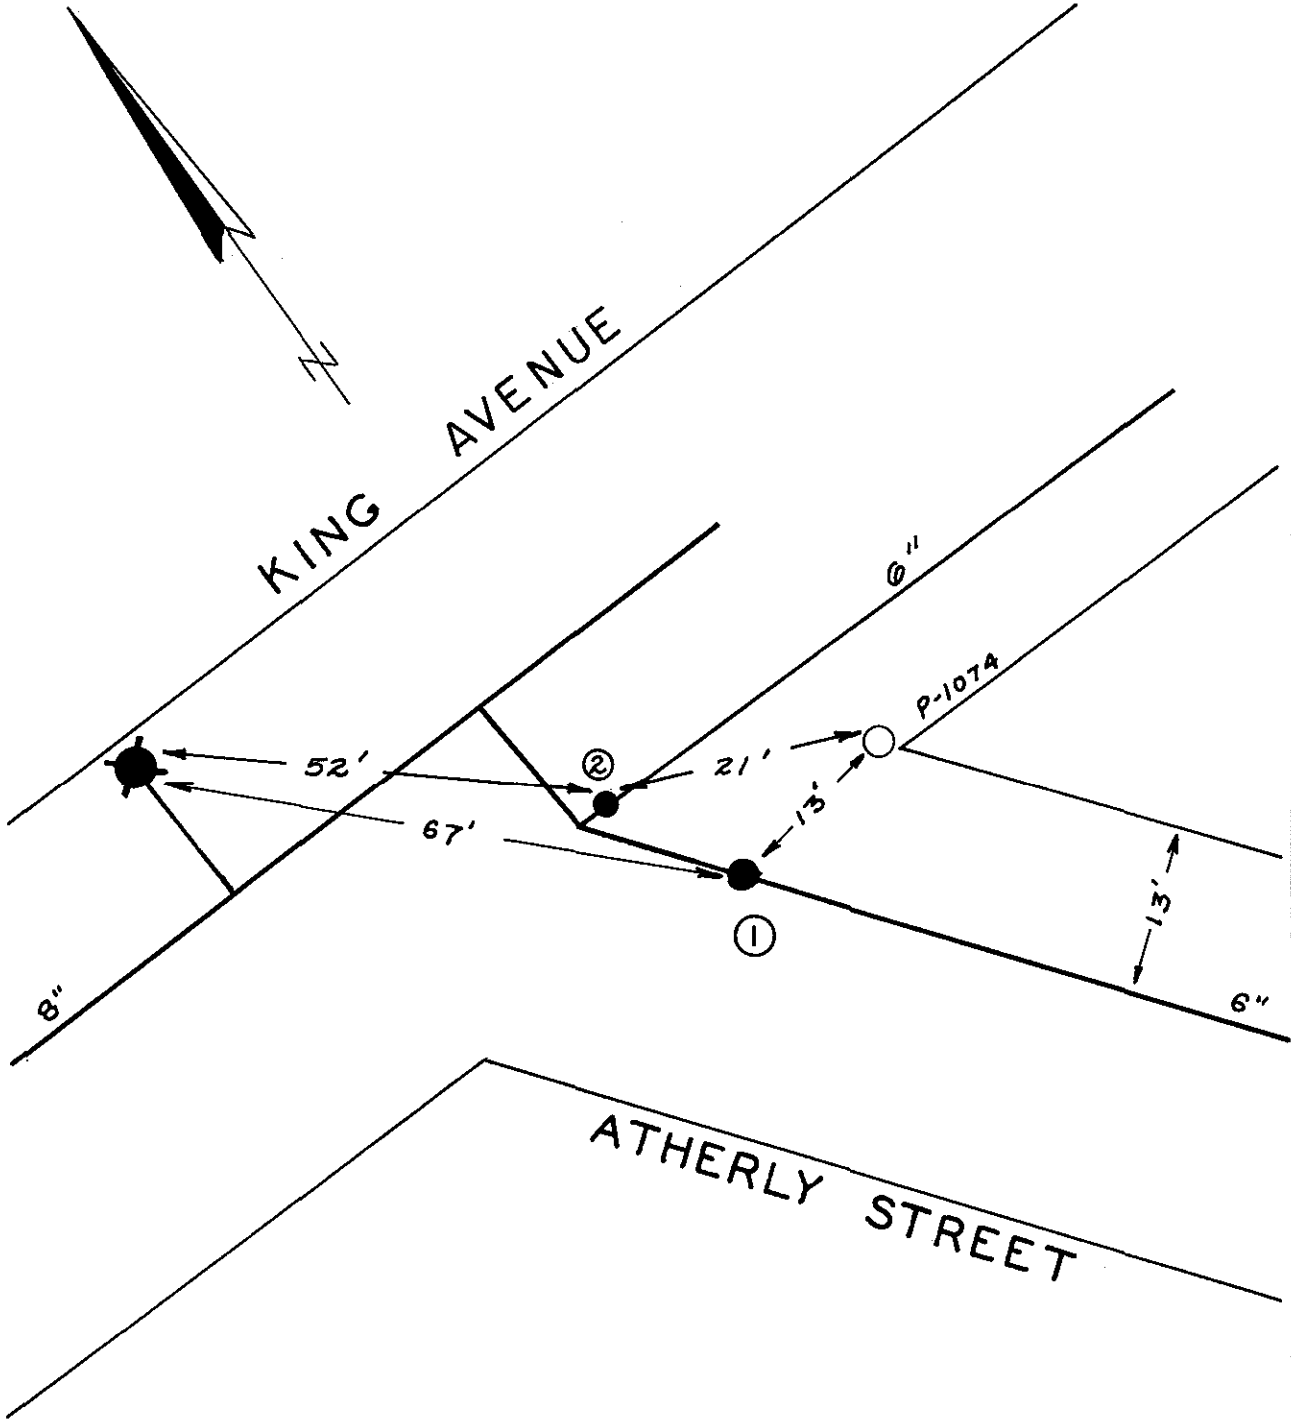

DATE	NO.	SIZE	MAKE	OPEN	TURNS
1952	1	6"		R	
1977	2	6"	MUELLER	R	
	1	0	SPL		

CITY OF ROANOKE — WATER DEPT.

VALVE DIAGRAM

ATHERLY ST. &

KING AVENUE

SEC. MAP 341, 704 N.E.

DATE PAGE NO.

8/2000 JH