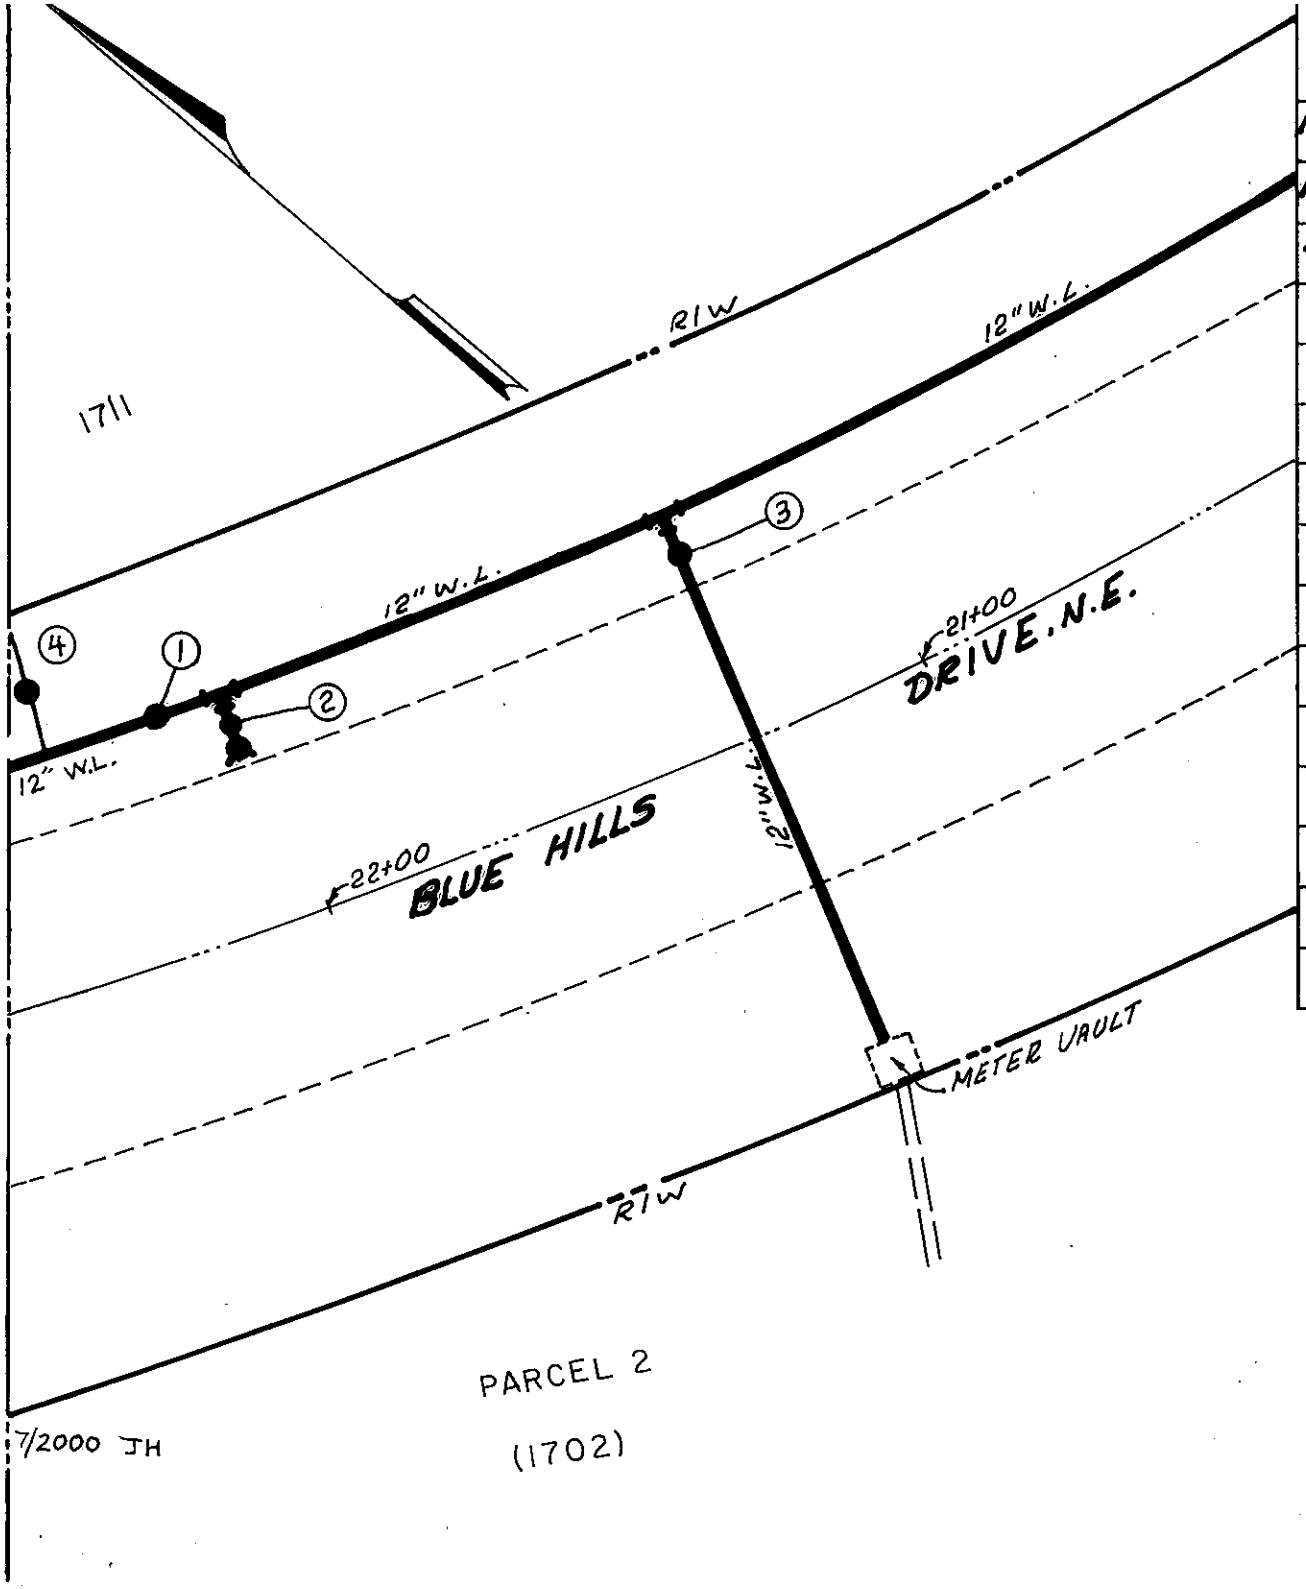

DATE	NO.	SIZE	MAKE	OPEN	TURNS
12/64	1	12"			
12/64	2	6"			
12/64	3	12"			
	4				

CITY OF ROANOKE—WATER DEP'T

VALVE DIAGRAM

BLUE HILLS DRIVE, N.E.

SEC. MAP 721

DATE 4-11-85 PAGE NO. 48