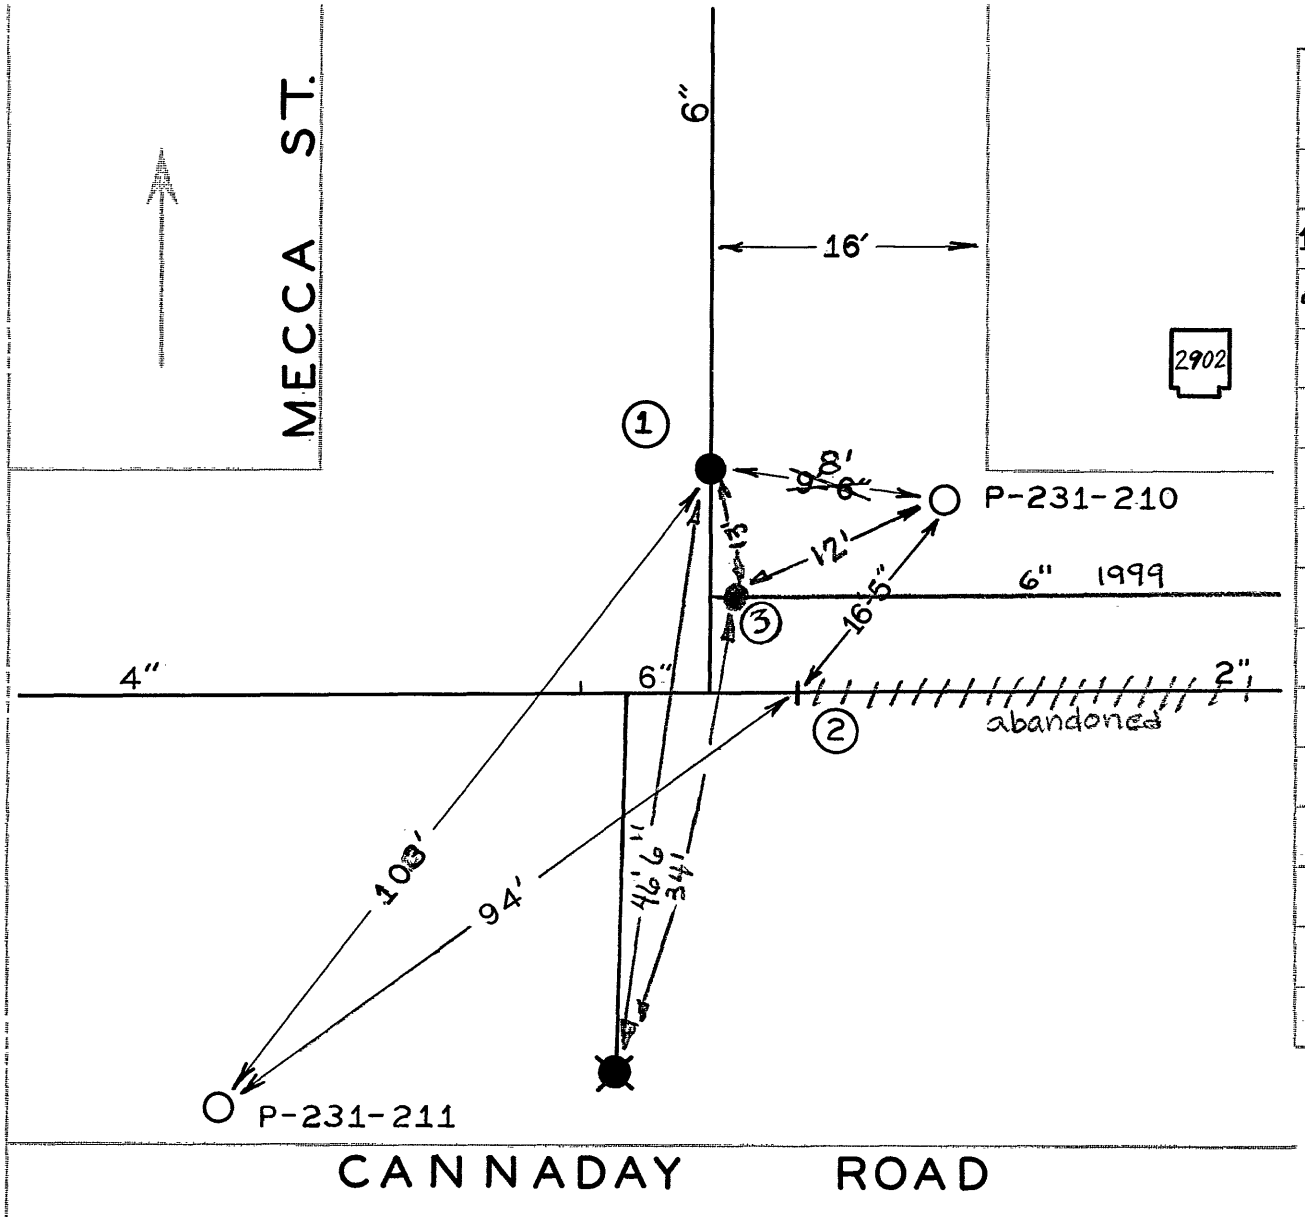

DATE	NO.	SIZE	MAKE	OPEN	TURNS
57	1	6"	MUELLER	R	20½
~~11-67~~	~~2~~	~~2"~~	~~MUELLER~~	~~R~~	
9-99	3	6"	Darling	R	21
	1	0	NPL		
	2	13'	EPL		

CITY OF ROANOKE—WATER DEP'T

VALVE DIAGRAM

CANNADAY RD. &

MECCA ST. N.E.

NORTH INTERSECTION

SEC. MAP 707, 708

DATE PAGE NO.

9/2000 JH