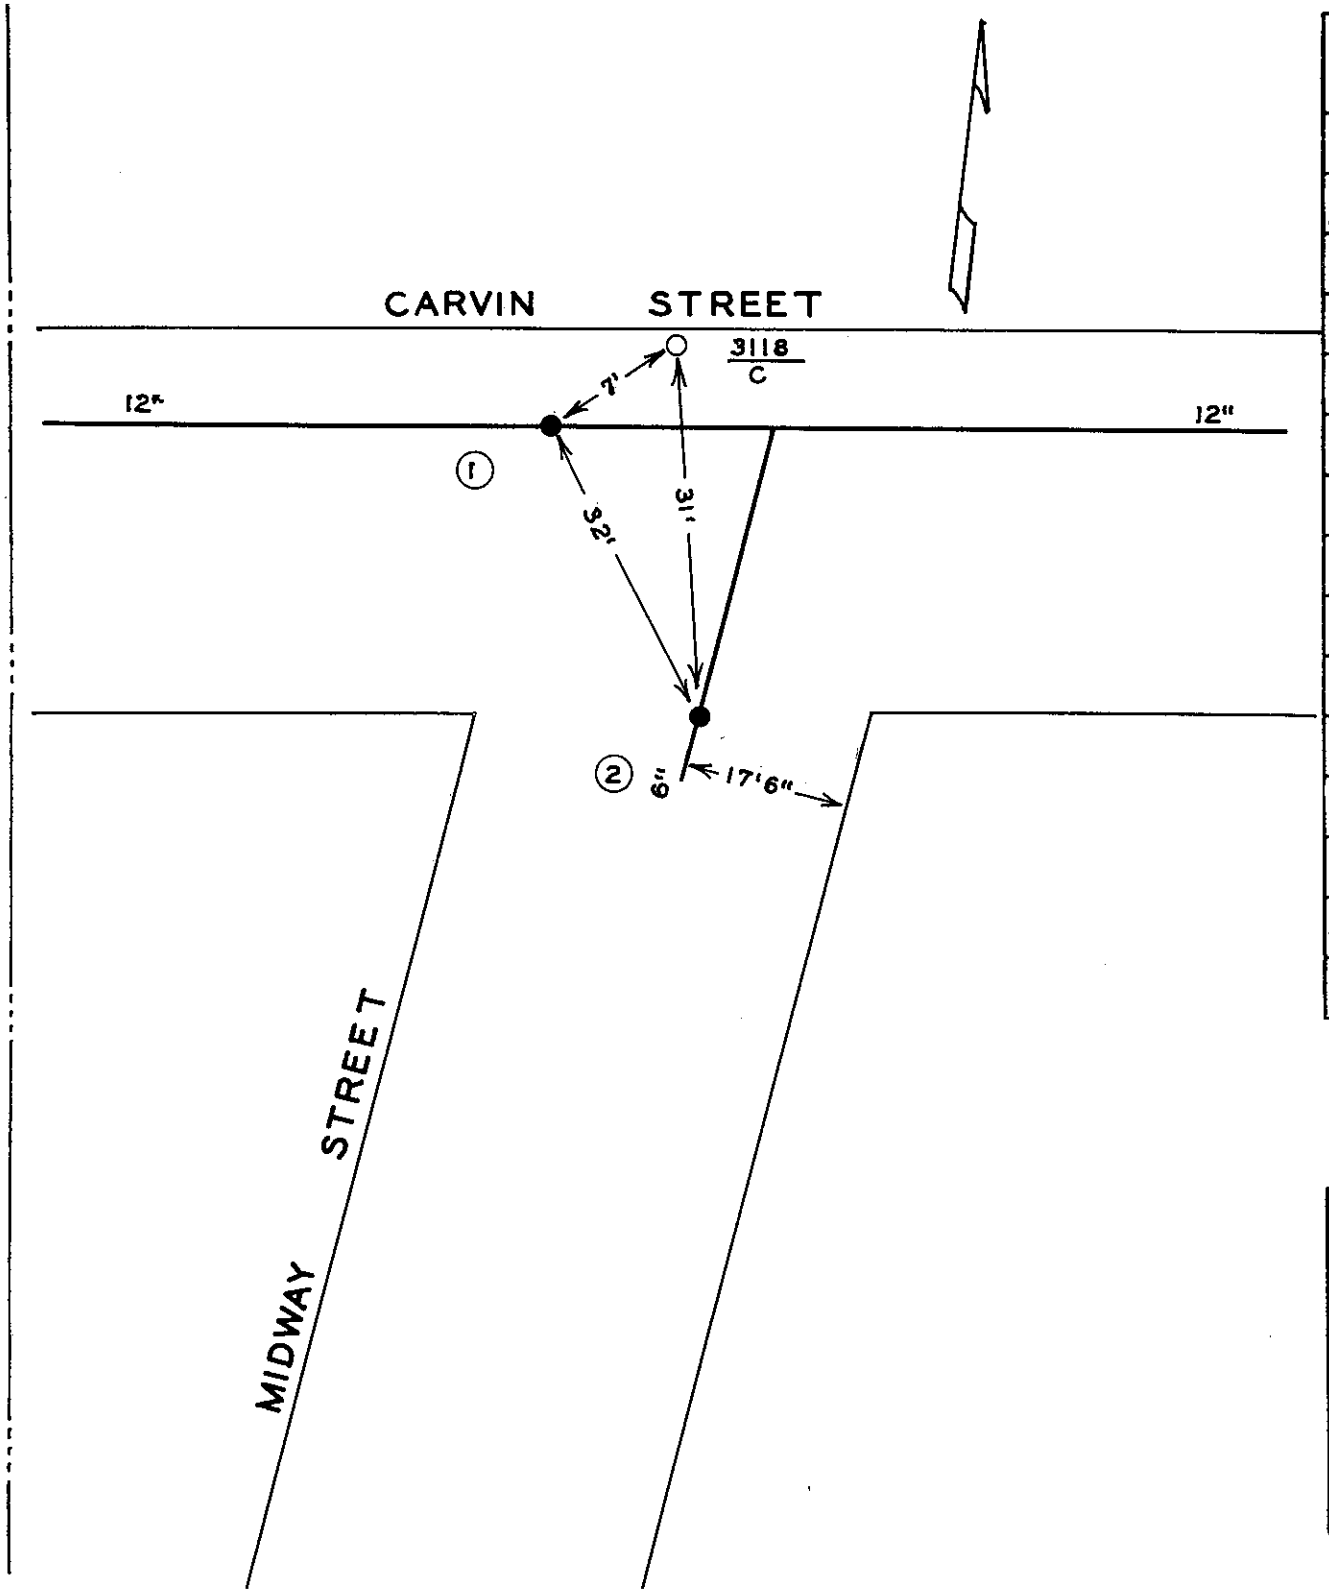


| DATE | NO. | SIZE | MAKE | OPEN | TURNS |
|---|---|---|---|---|---|
| 5-65 | 1 | 12 | MUELLER | R | |
| 5-65 | 2 | 6 | MUELLER | R | |
| | | | | | |
| | | | | | |
| | | | | | |
| | | | | | |
| | | | | | |
| | | | | | |
| | | | | | |
| | | | | | |
| | | | | | |
| | 1 | 0 | W.P.L. | | |
| | 2 | 0 | S.P.L. | | |
| | | | | | |
| | | | | | |

**CITY OF ROANOKE—WATER DEPT.**

**VALVE DIAGRAM**

CARVIN STREET &

MIDWAY STREET N.E.

SEC. MAP 333

DATE PAGE NO.