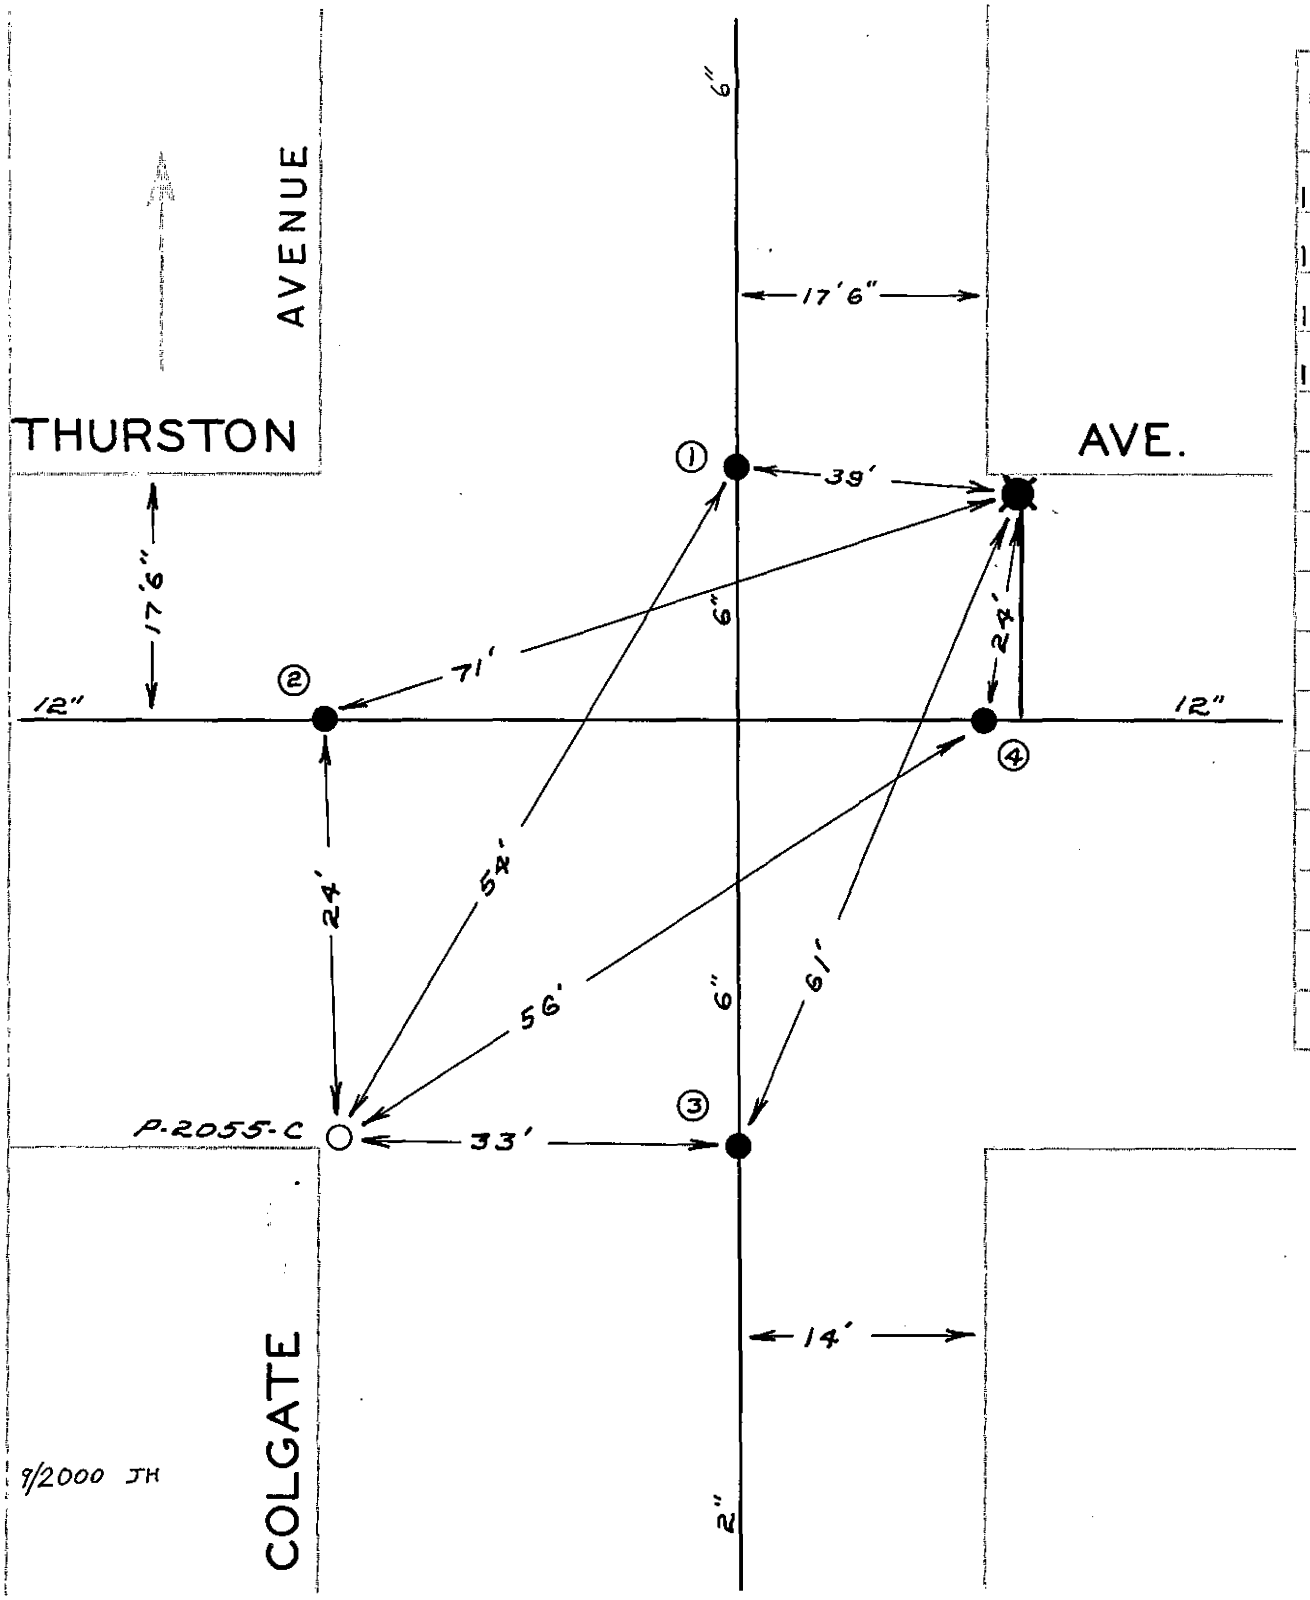

DATE	NO	SIZE	MAKE	OPEN	TURNS
1962	1	6"	MUELLER	R	
1956	2	12"	MUELLER	R	
1956	3	6"	MUELLER	R	
1956	4	12"	MUELLER	R	
	1	0	NPL		
	2	0	WPL		
	3	0	SPL		
	4	0	EPL		

CITY OF ROANOKE - WATER DEPT

VALVE DIAGRAM

COLGATE ST &

THURSTON AVE. N. E.

SEC. MAP 311

DATE PAGE NO