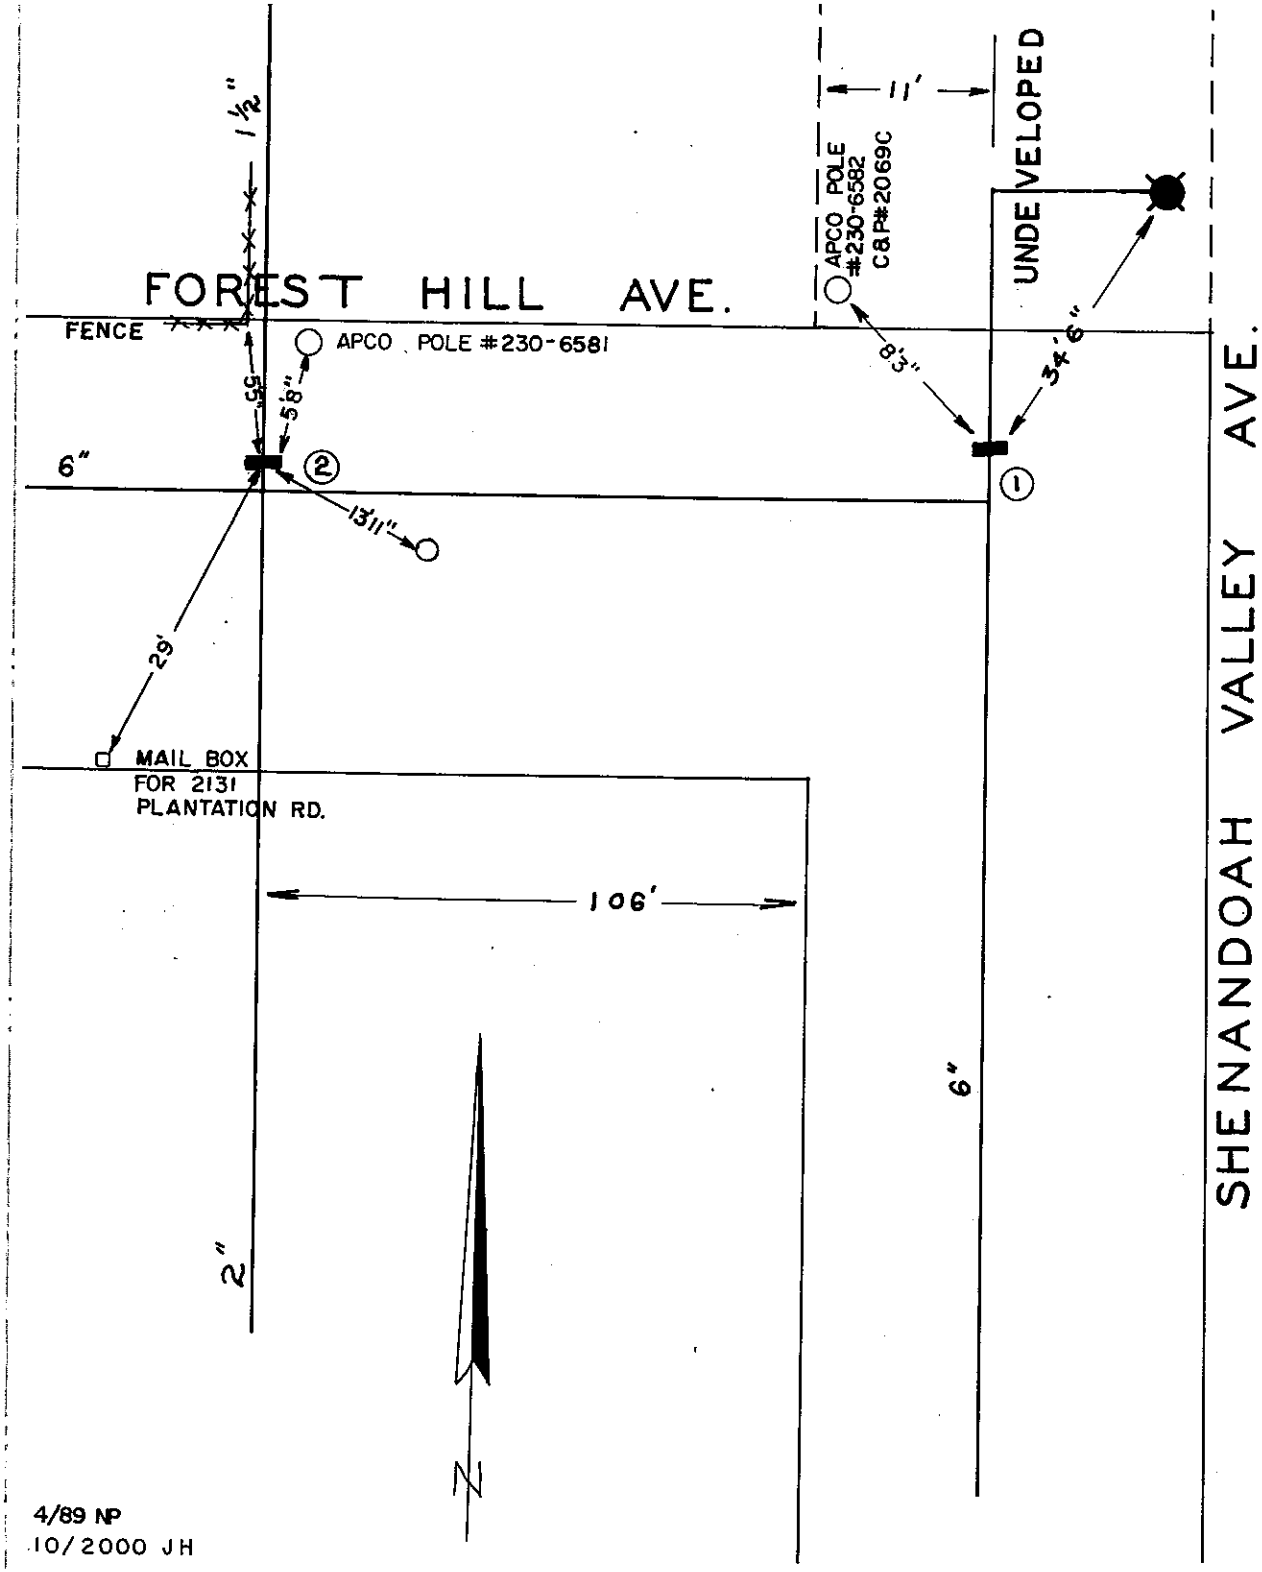

DATE	NO.	SIZE	MAKE	OPEN	TURNS
1951 W.R.	1	6"			
1951 W.R.	2	2"			
	1	6" S	NPL		
	2	6"-S	NPL		

CITY OF ROANOKE—WATER DEPT.

VALVE DIAGRAM

FOREST HILL AVE. &

SHENANDOAH VALLEY

AVE.

SEC. MAP 312 N.E.

DATE PAGE NO.

4/89 NP

10/2000 JH