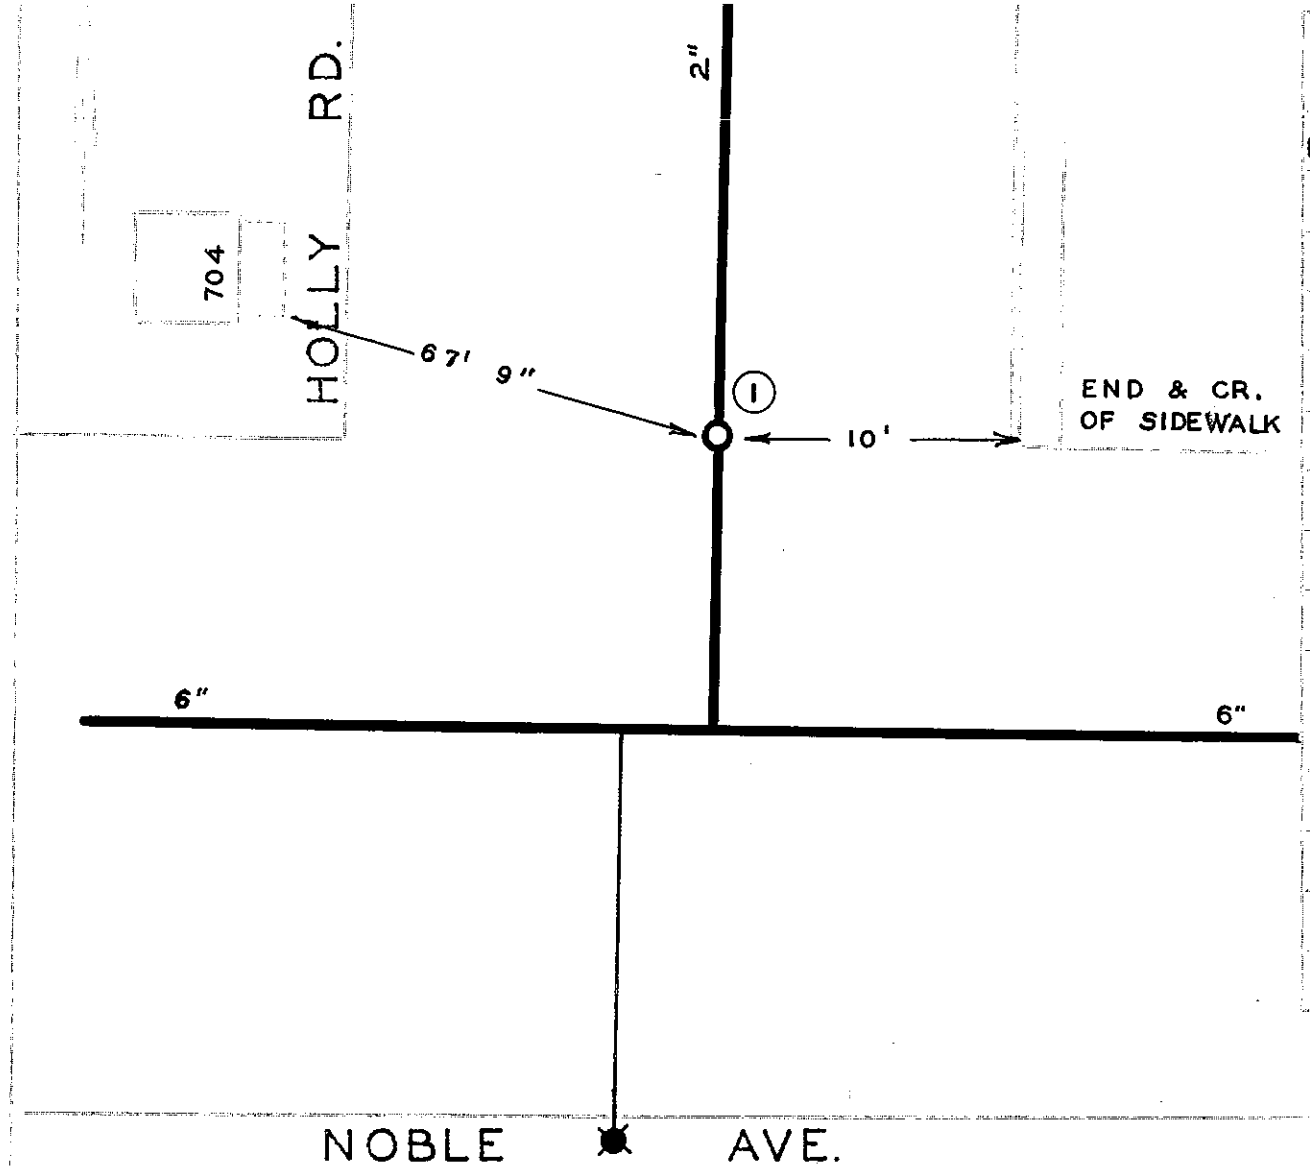

DATE	NO	SIZE	NAME	MAPP	PG
1926	1	2		R	8
	1	0	N PL		

VALVE DIAGRAM

HOLLY RD. &
NOBLE AVE.

FIG. NO. 311 N.E.

DATE NE 86

10/2000 JH