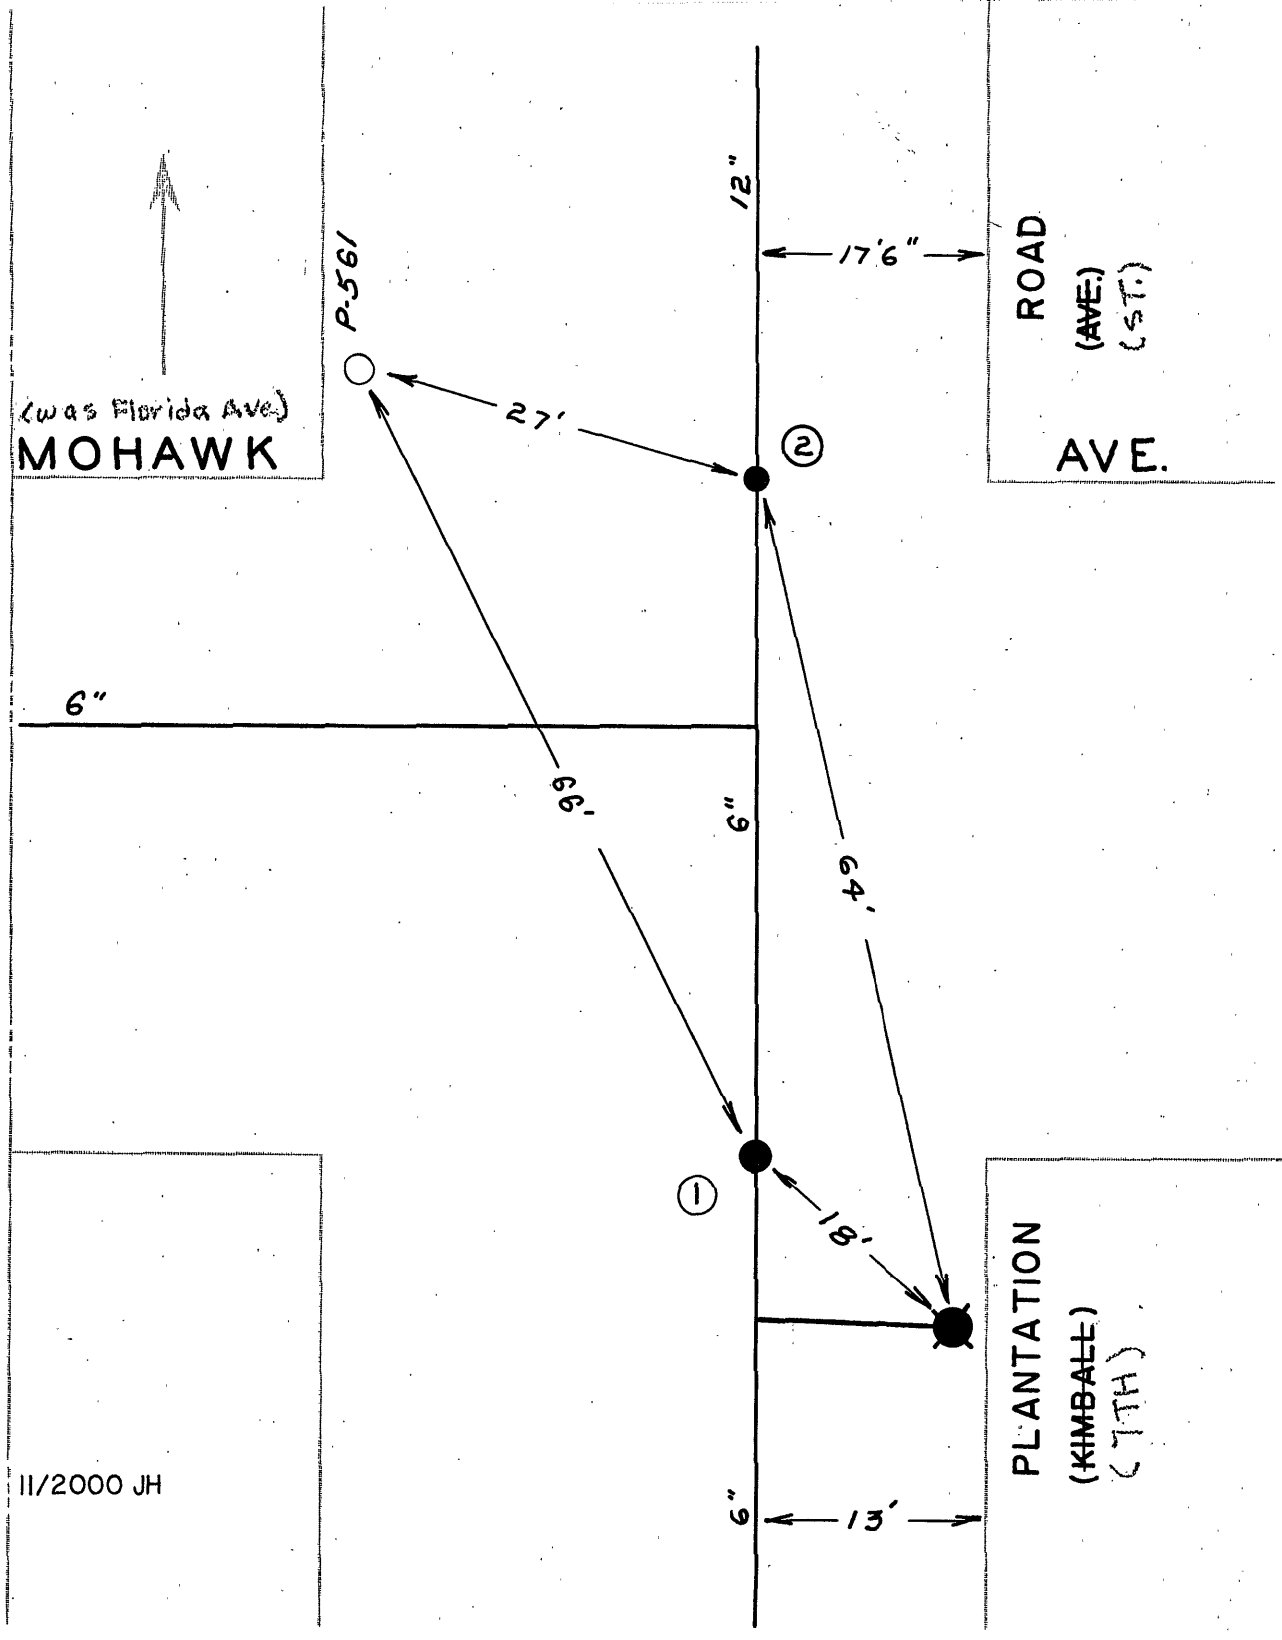


| DATE | NO. | SIZE | MAKE | OPEN | TURNS |
|---|---|---|---|---|---|
| 1952 | 1 | 6" | MUELLER | R | 20 |
| 1957 | 2 | 12" | DALING | R | |
| | | | | | |
| | | | | | |
| | 1 | 0 | SPL | | |
| | 2 | 0 | NPL | | |

CITY OF ROANOKE — WATER DEP'T

VALVE DIAGRAM

MOHAWK AVENUE

PLANTATION

or 7TH ST

SEC. MAP 304 N.E.

DATE PAGE NO.