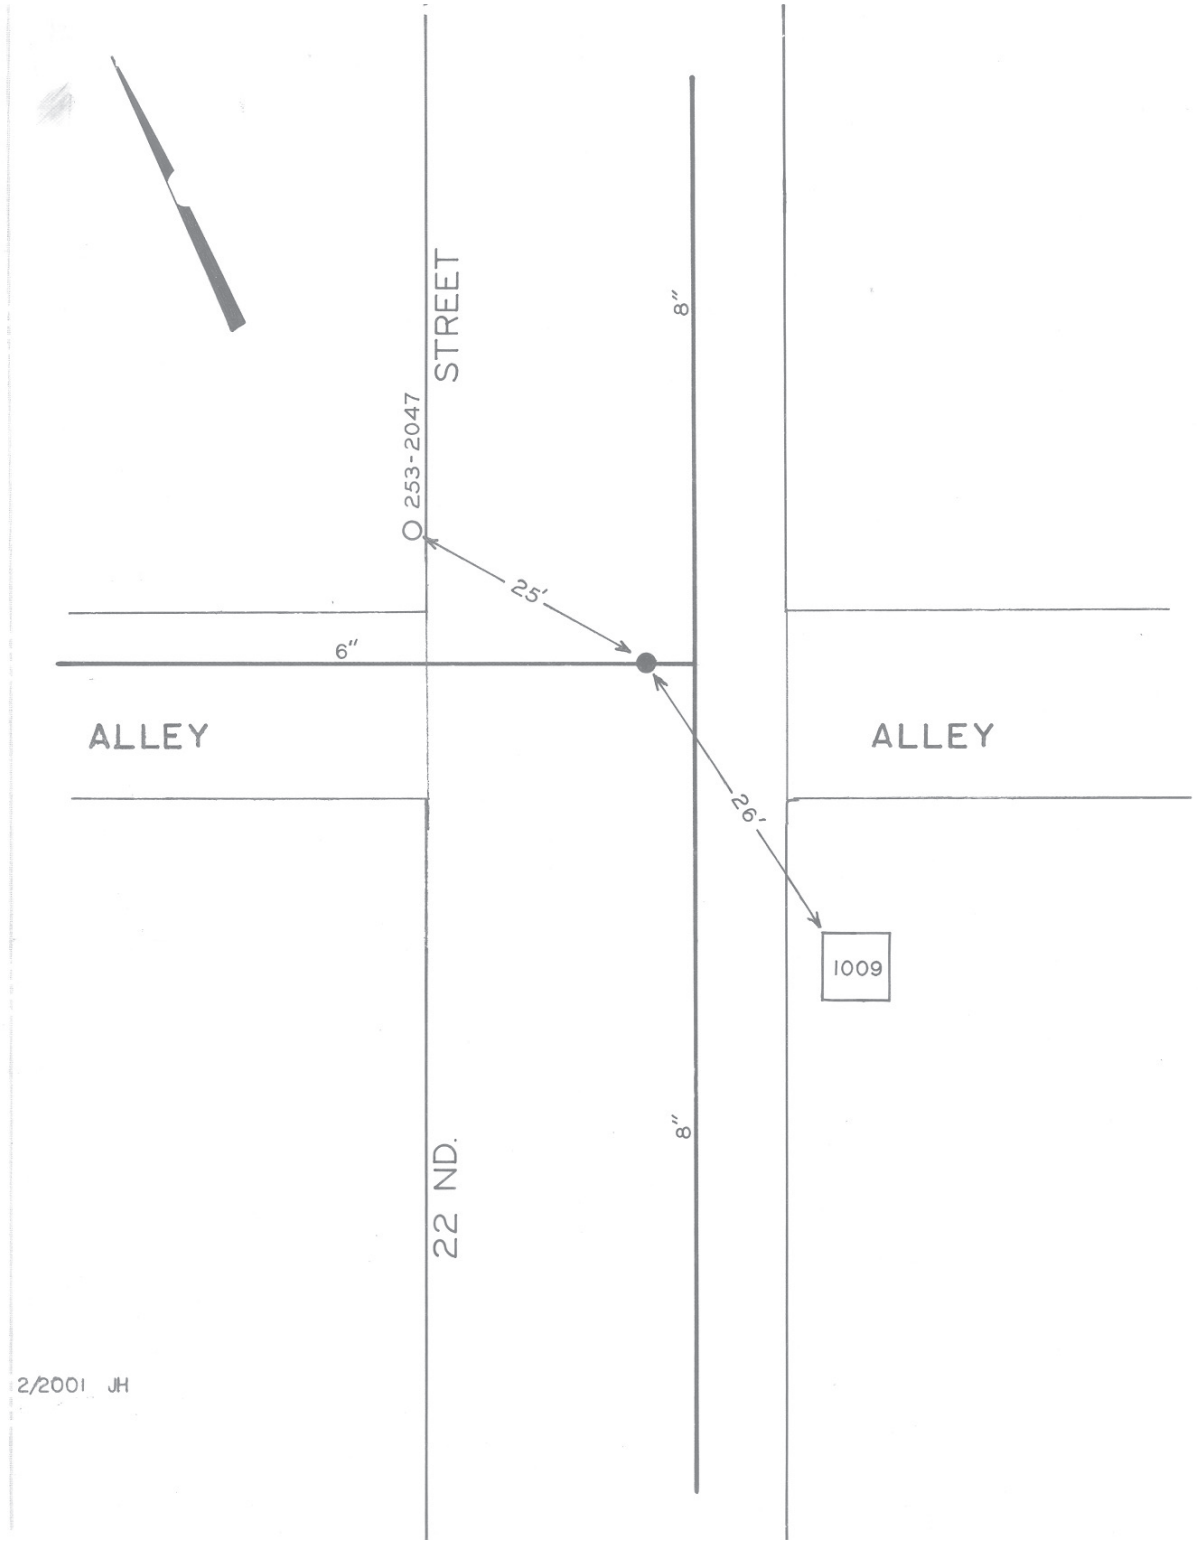

DATE	NO.	SIZE	MAKE	OPEN	TURNS
71	1	6"	DARLING	R	
	1	15'-W	E.P.L.		

2/2001 JH

CITY OF ROANOKE — WATER DEP'T

VALVE DIAGRAM

22 ND. STREET N.W.

1000 BLOCK

SEC. MAP 233 N.W.

DATE PAGE NO.