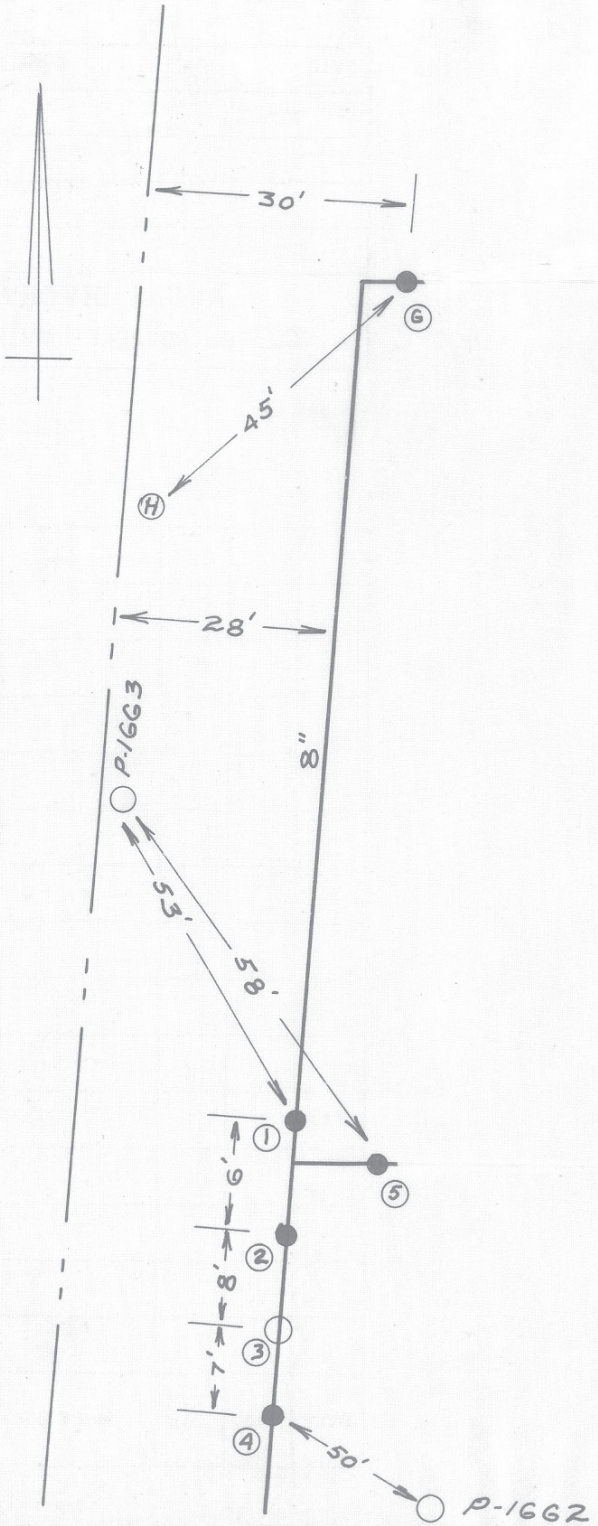

DATE	NO.	SIZE	MAKE	OPEN	TURNS
5-51	1	8"	Darling		
5-51	2	8"	Darling		
5-51	3	Meter			
5-51	4	8"	Darling		
5-51	5	8"	Darling		
5-51	6	8"	Darling		

CITY OF ROANOKE — WATER DEPT.

VALVE DIAGRAM

5TH. ST. N.W. AT

CITY DUMP

SEC. MAP 203

DATE PAGE NO.

IMPERIAL TRACING CLOTH
K & E CO., N. Y.