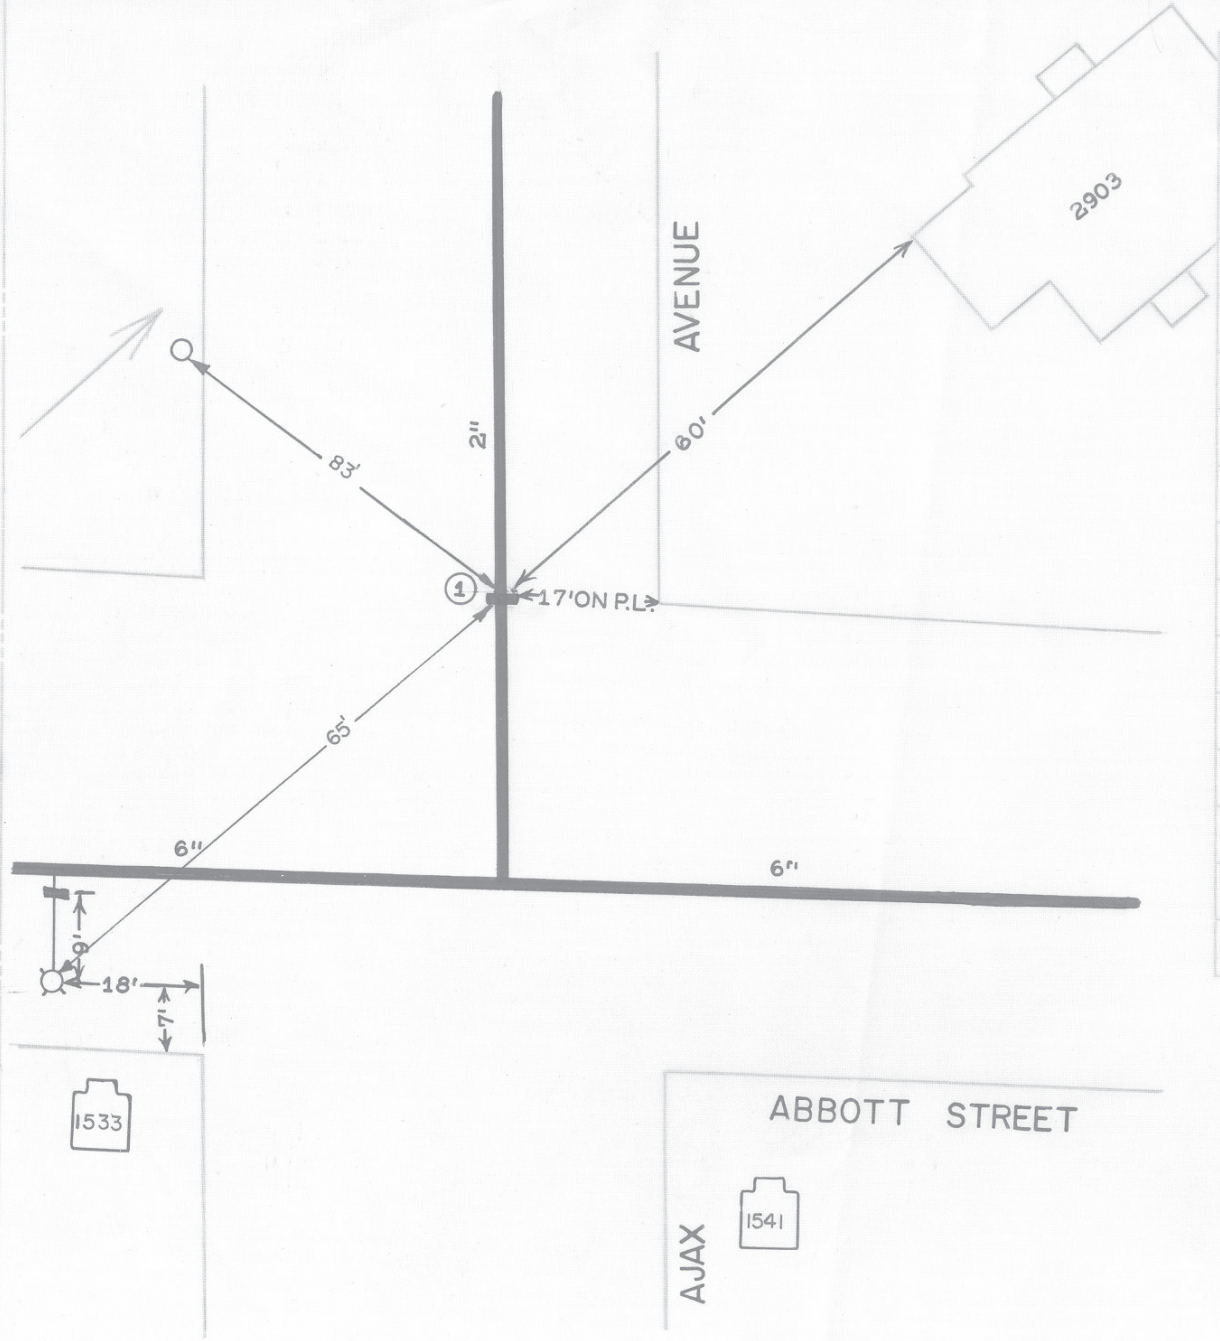

DATE	NO.	SIZE	MAKE	OPEN	TURNS
1950	1	2"	DARLING	R	$7\frac{1}{2}$

Scale 1" = 20'

CITY OF ROANOKE—WATER DEP'T

VALVE DIAGRAM

ABBOTT STREET &

AJAX AVENUE N.W.

SEC. MAP 246

DATE

PAGE NO. N.W.324

2/87 NP