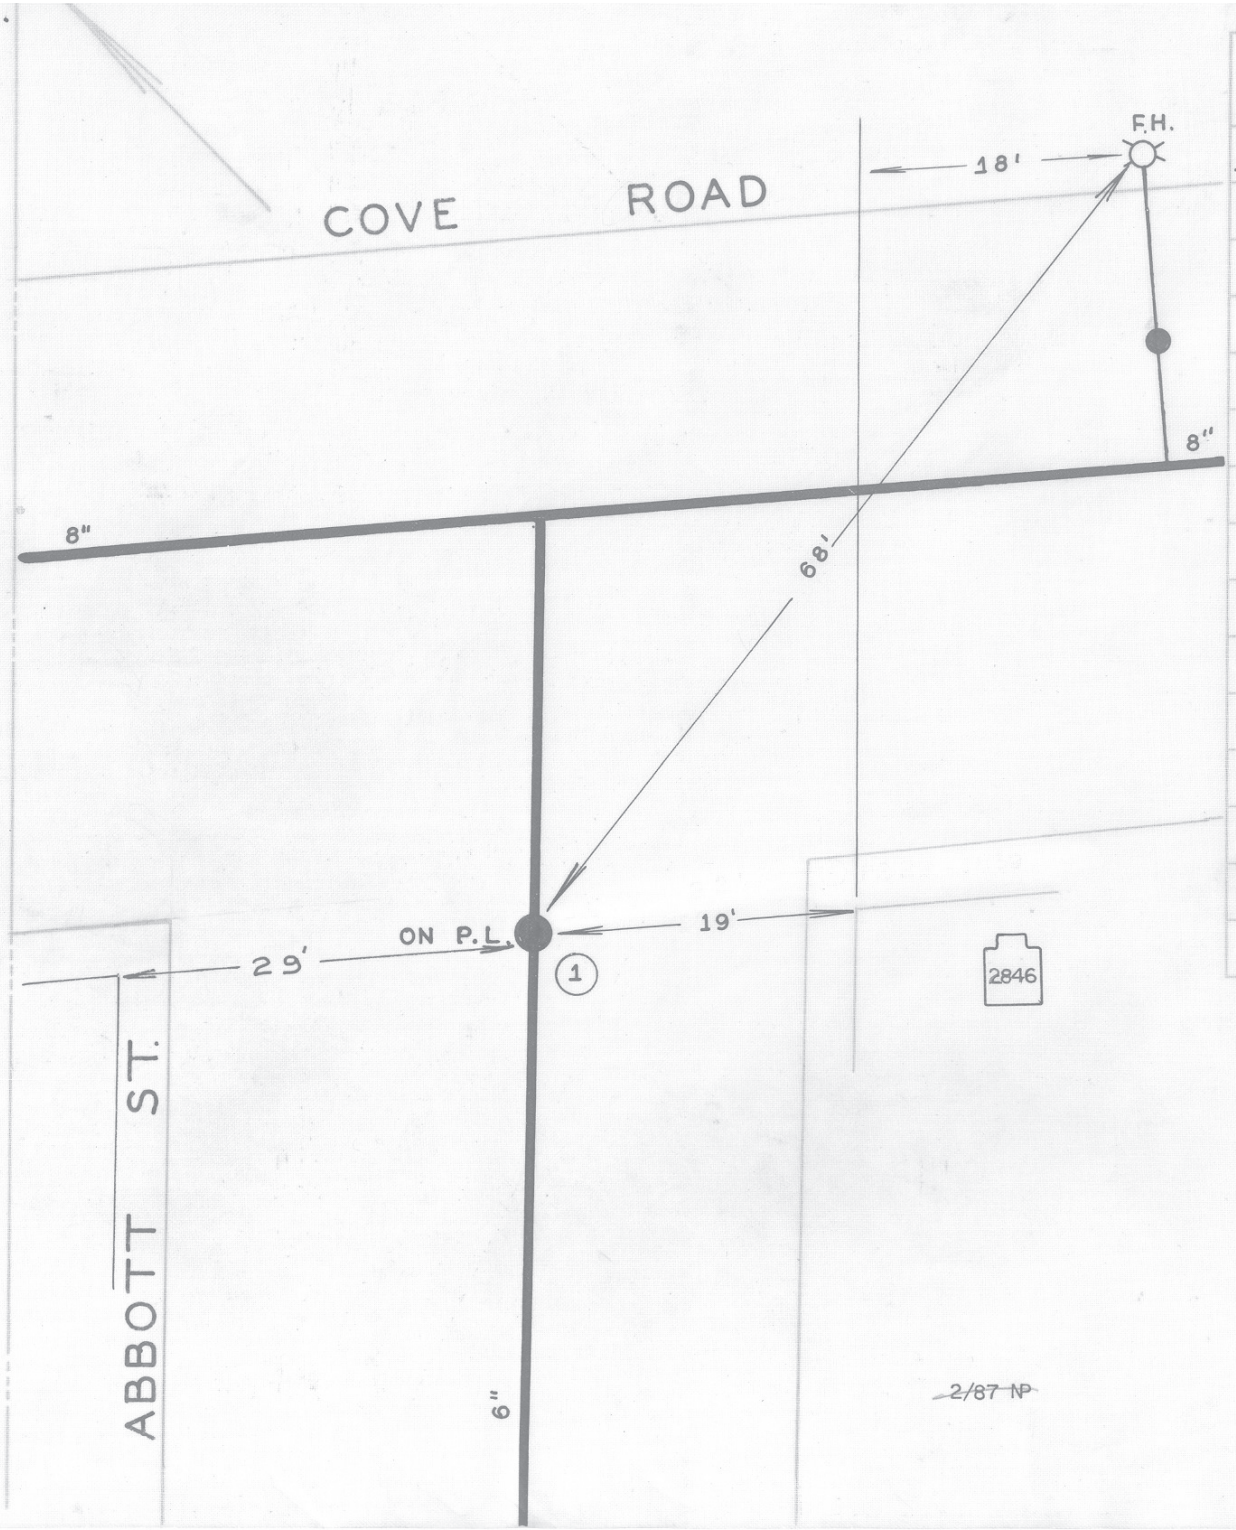

DATE	NO.	SIZE	MAKE	OPEN	TURNS
1950	1	6"	DARLING	R	21
	1	10'-S	SPL		

need new mont.

CITY OF ROANOKE — WATER DEP'T

VALVE DIAGRAM

ABBOTT STREET &

COVE ROAD N.W.

SEC. MAP 246

DATE PAGE NO. NW350

2/87 NP