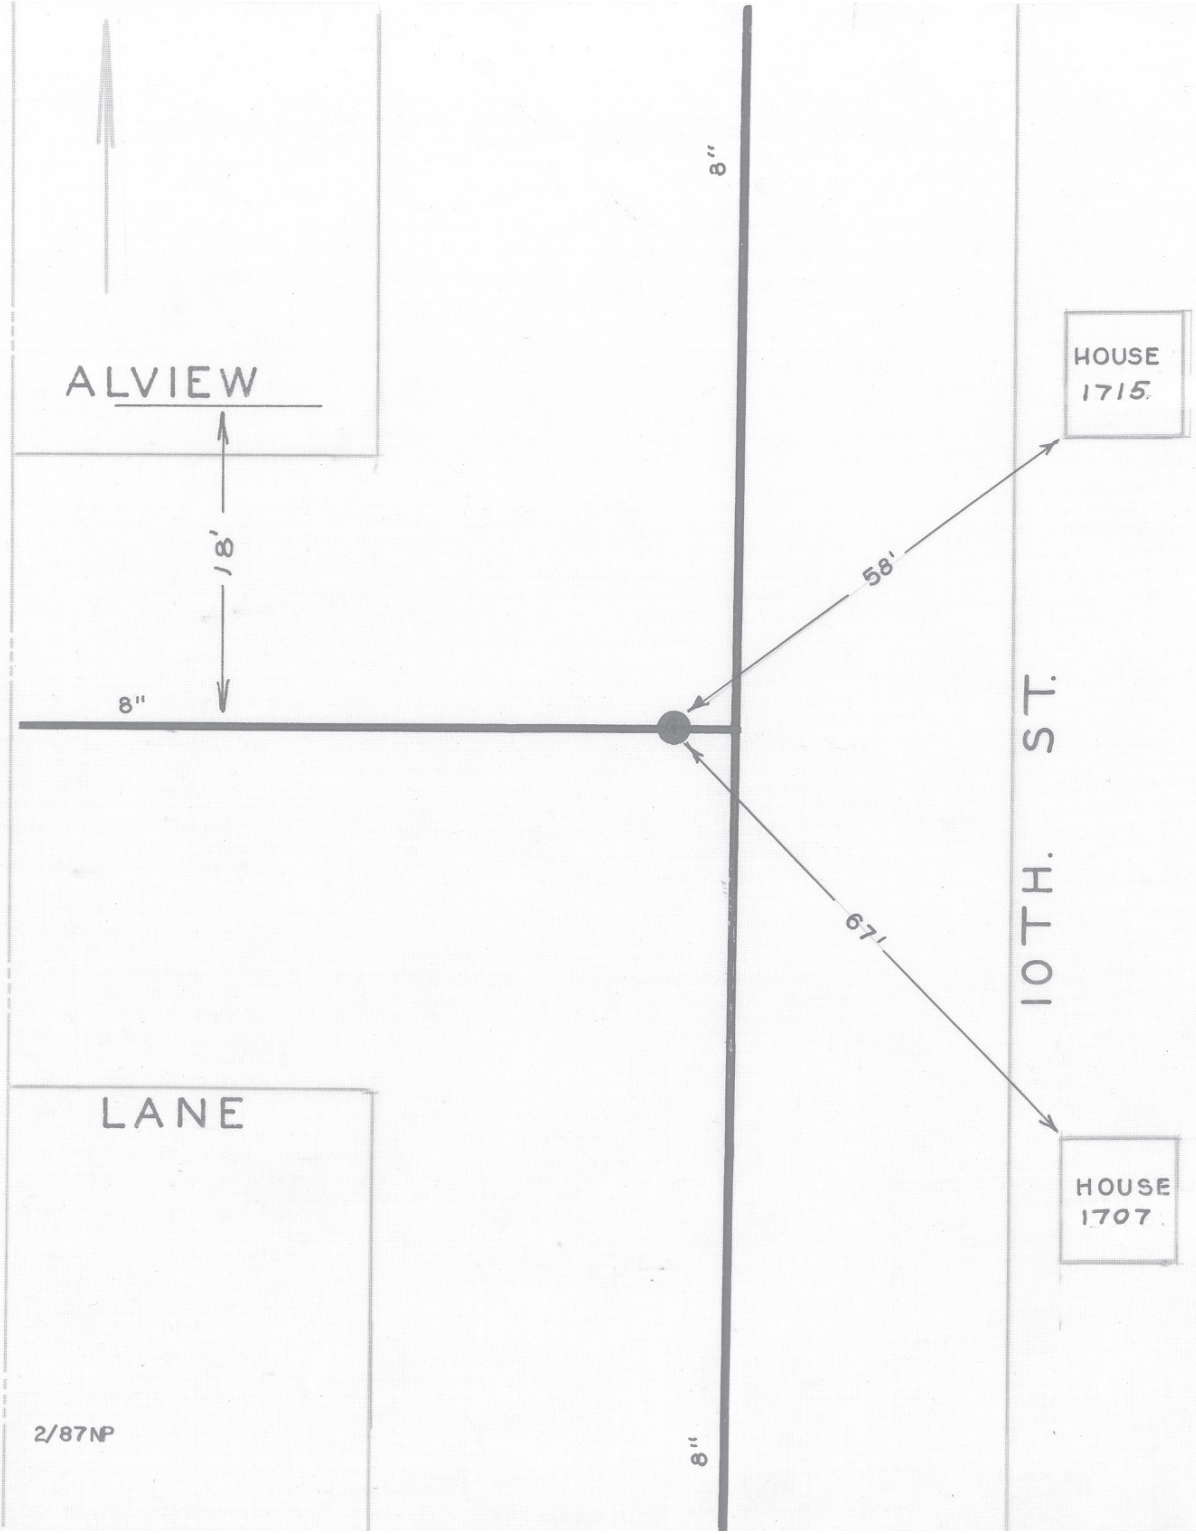

DATE	NO.	SIZE	MAKE	OPEN	TURNS
1948	1	6	A.P. SMITH TAPPING VALVE	R	21
	1	29'-E	WPL		

CITY OF ROANOKE—WATER DEP'T

VALVE DIAGRAM

ALVIEW LANE & 10TH. STREET N.W.

SEC. MAP 213

DATE 11/15/48 PAGE NO. NW 313