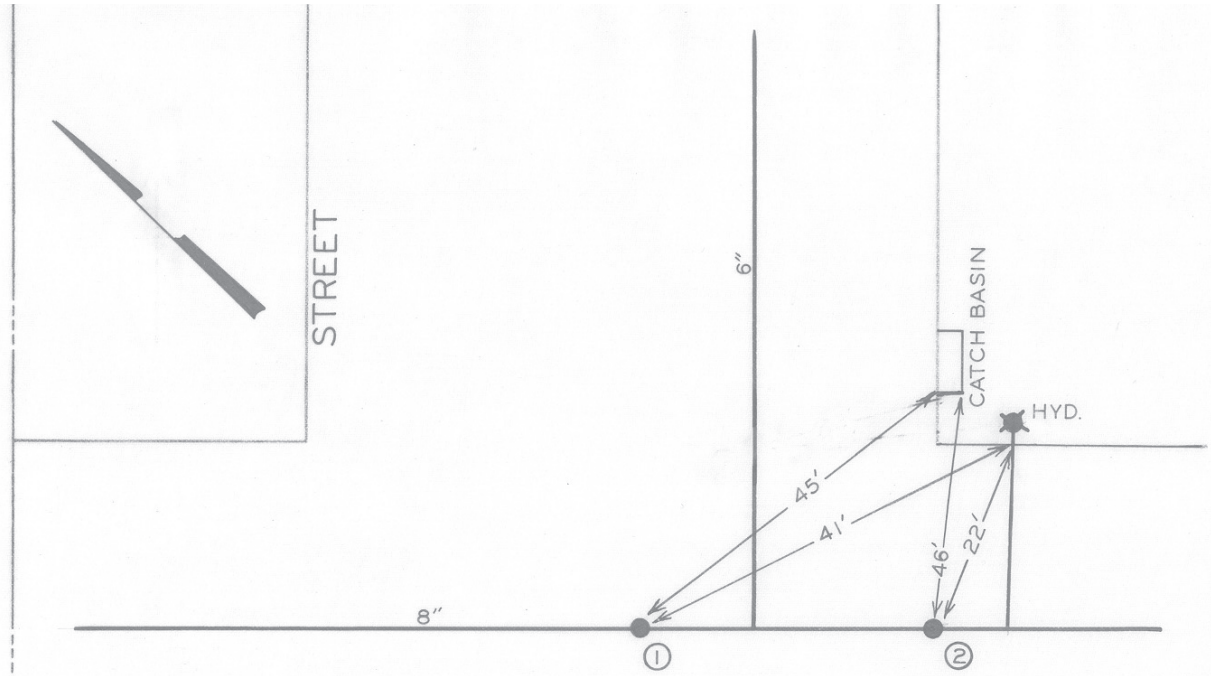

DATE	NO.	SIZE	MAKE	OPEN	TURNS
69	1	8"	MUELLER	R	
69	2	8"	MUELLER	R	

ANDREWS

ROAD

1602

16TH

2/87 NP

CITY OF ROANOKE—WATER DEP'T

VALVE DIAGRAM

ANDREWS RD. & 16TH ST. N.W.

SEC. MAP 224

DATE PAGE NO.