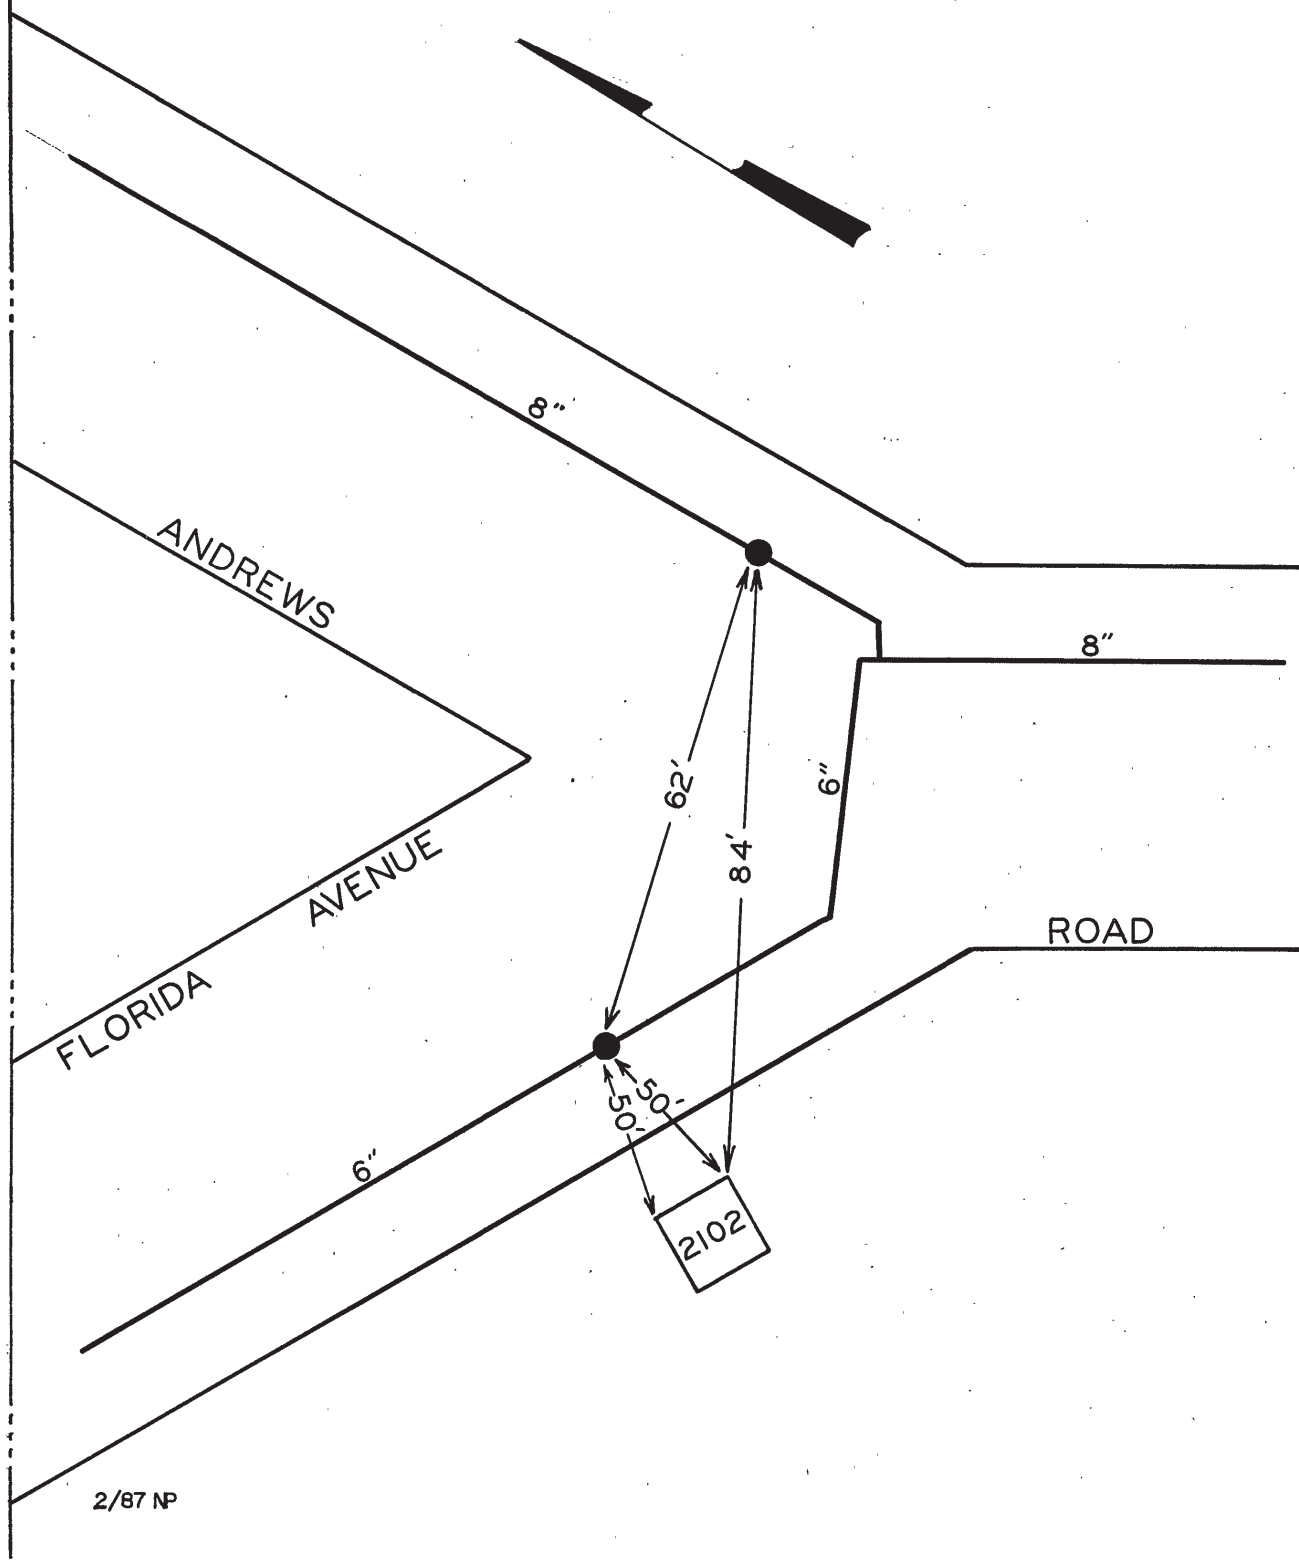

DATE	NO.	SIZE	MAKE	OPEN	TURNS
2-69	1	8"	MUELLER	R	
2-69	2	6"	MUELLER	R	

CITY OF ROANOKE—WATER DEPT.

VALVE DIAGRAM

ANDREWS RD. & FLORIDA AVE. N.W.

SEC. MAP 235

DATE **PAGE NO.**

2/87 NP