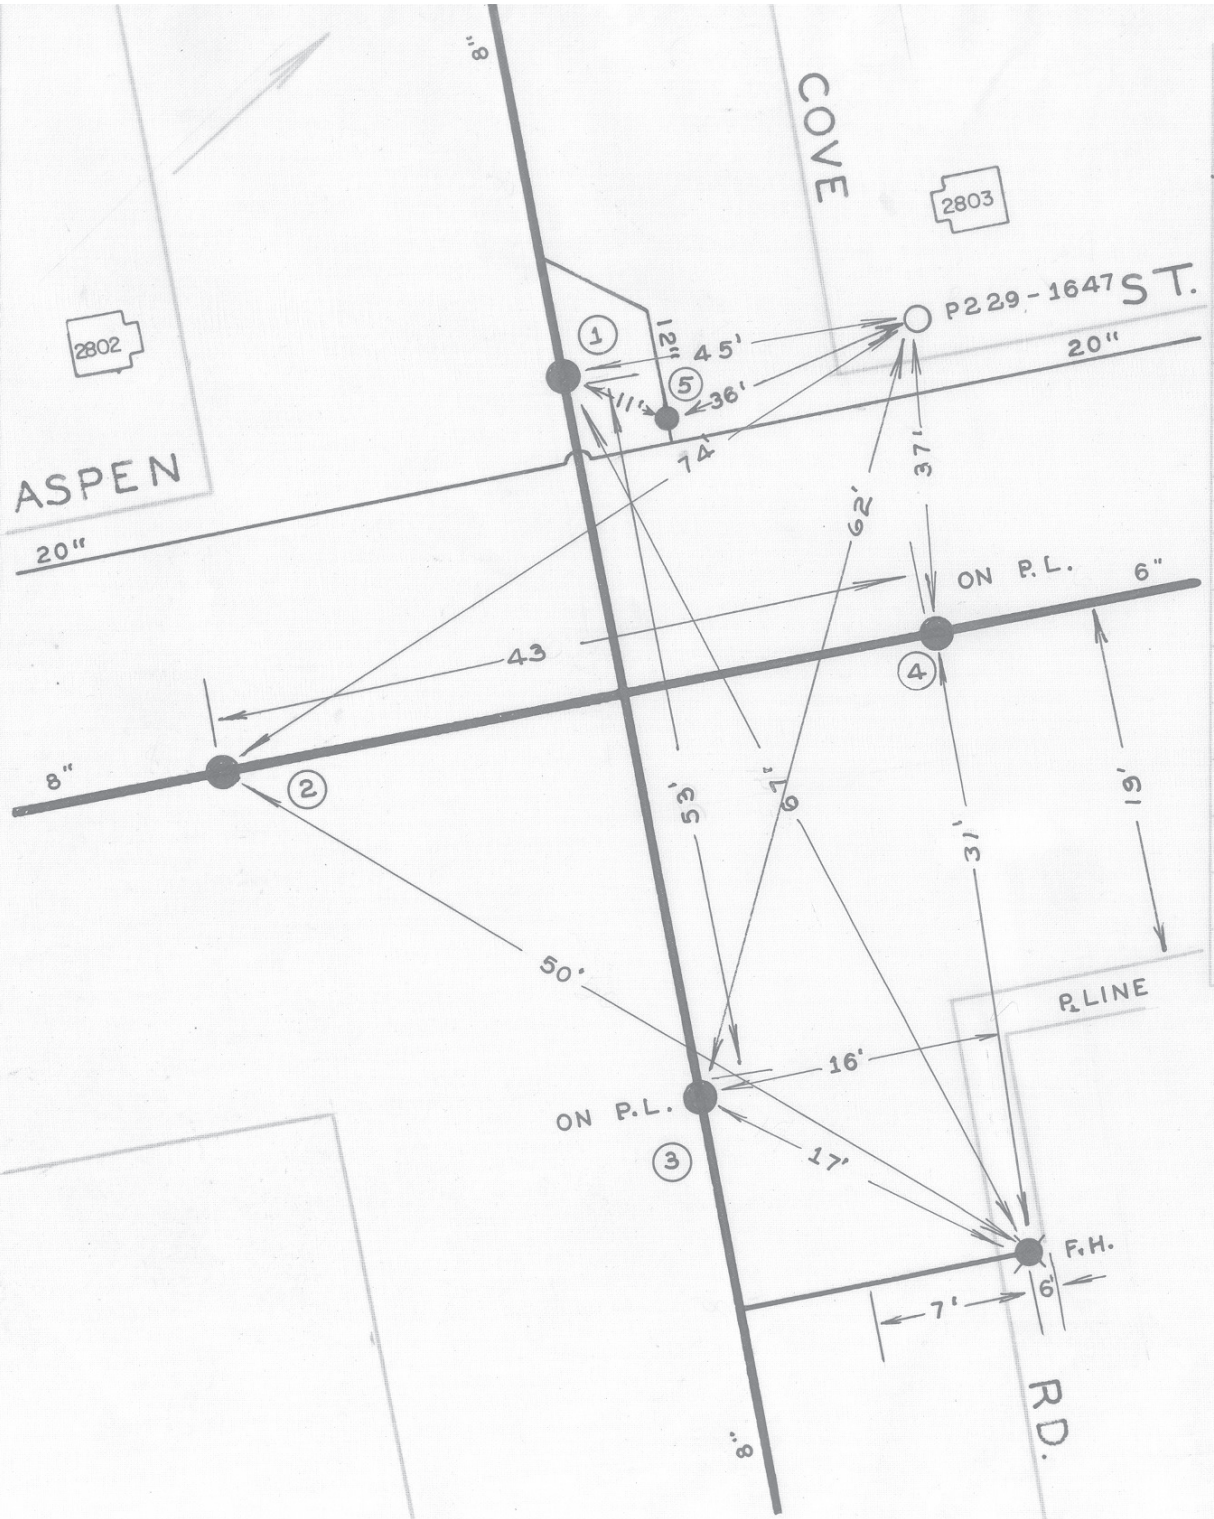

DATE	NO.	SIZE	MAKE	OPEN	TURNS
1949	1	8"	DARLING	R	27
1950	2	8"	DARLING	R	27
1950	3	8"	DARLING	R	27
1947	4	6"	DARLING	R	20
12-64	5	12"	DARLING	R	
	1	0	WPL		
	2	0	SPL		
	3	0	EPL		
	4	0	NPL		

CITY OF ROANOKE—WATER DEP'T

VALVE DIAGRAM

ASPEN ST. & COVE ROAD N.W.

SEC. MAP 246 & 247

DATE PAGE NO. N.W. 289

2/87 NP