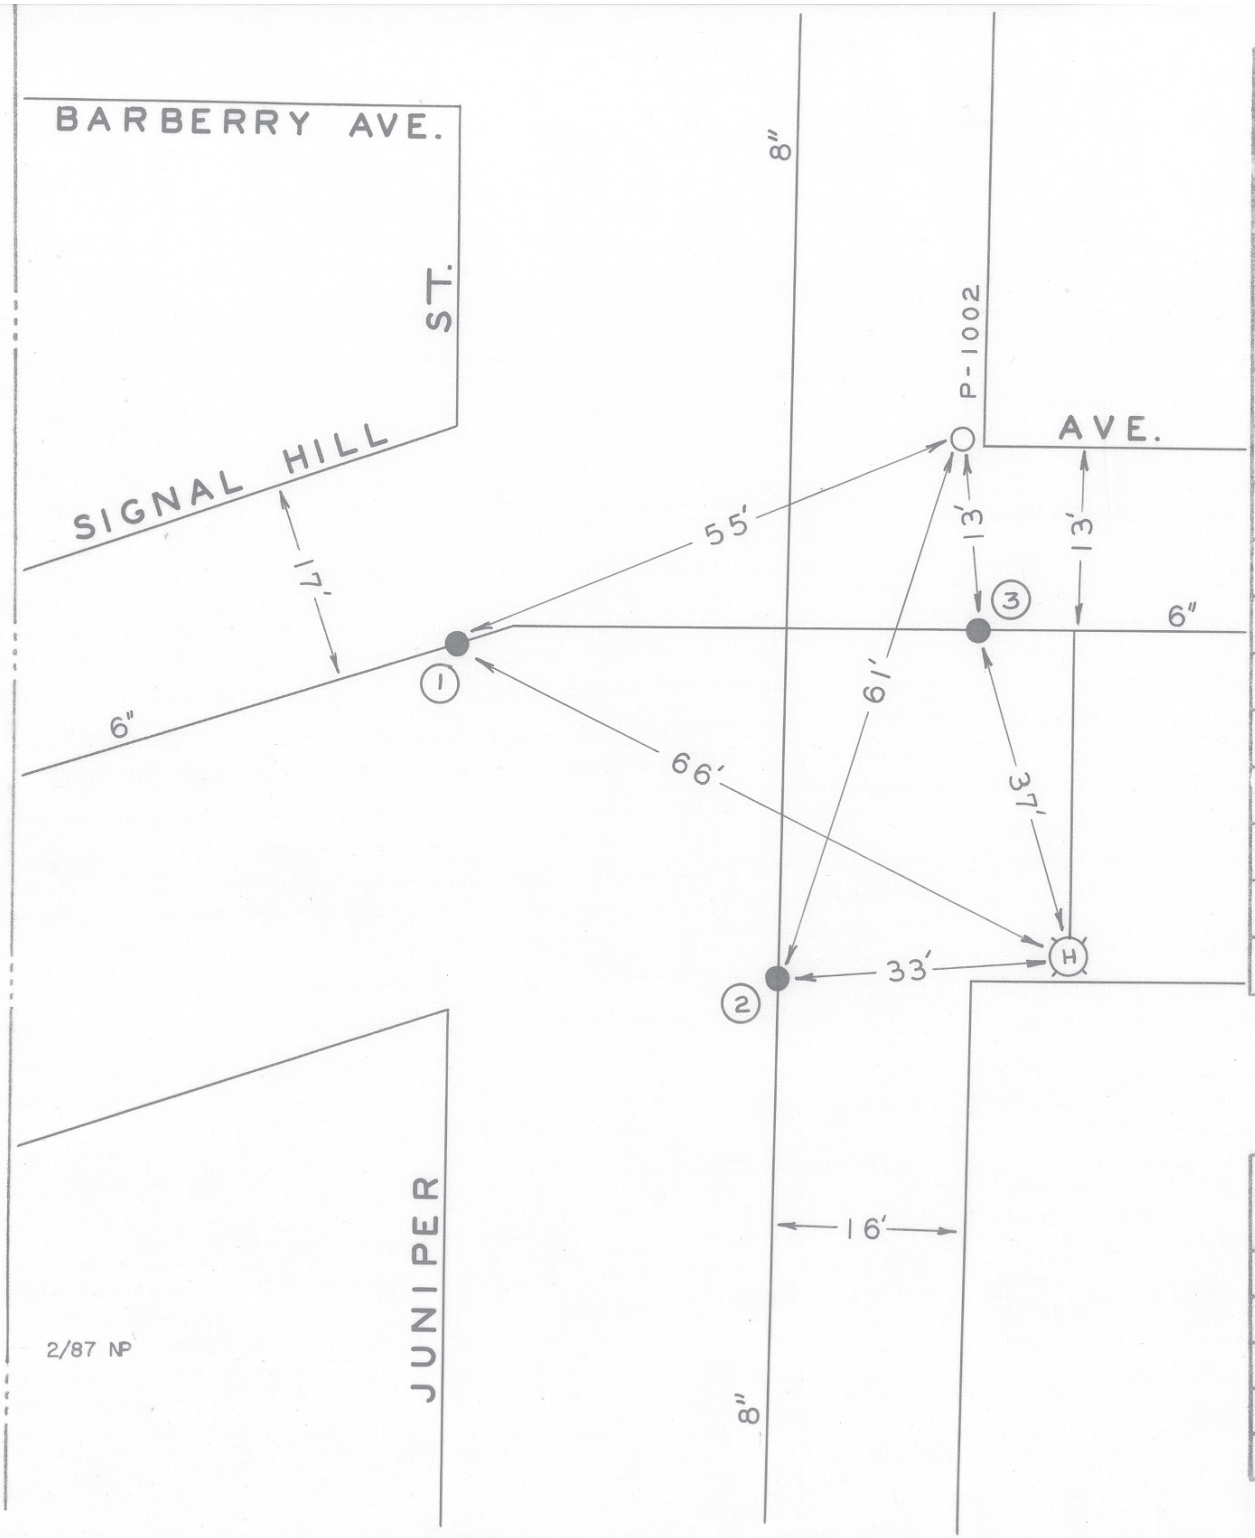

DATE	NO.	SIZE	MAKE	OPEN	TURNS
1953	1	6"	MUE.	R	20
1953	2	8"	MUE.	R	27
1953	3	6"	MUE.	R	20
	1	0	WPL		
	2	0	SPL		
	3	0	EPL		

CITY OF ROANOKE — WATER DEPT.

VALVE DIAGRAM

BARBERRY AVE. - JUNIPER ST. & SIGNAL HILL AVE. N.W.

SEC. MAP 263

DATE PAGE NO.