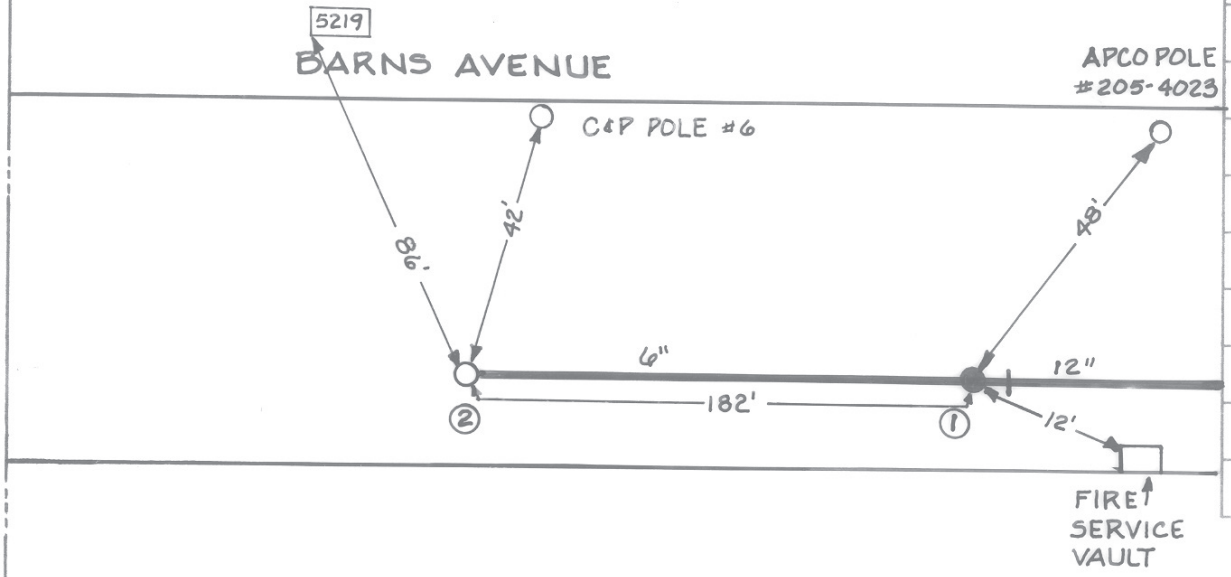

DATE	NO.	SIZE	MAKE	OPEN	TURNS
12-3-80	1	6"	MUELLER	R	
12-3 80	2	2"	BLOWOFF (CRANE)	L	
14'	FROM S.P.L. ②				
16'	FROM S.P.L. ①				

CITY OF ROANOKE — WATER DEP'T

VALVE DIAGRAM

5200 BLK. BARNS AVE.

N.W.

SEC. MAP 660

DATE PAGE NO.

1/87 NP

10/2000 JH