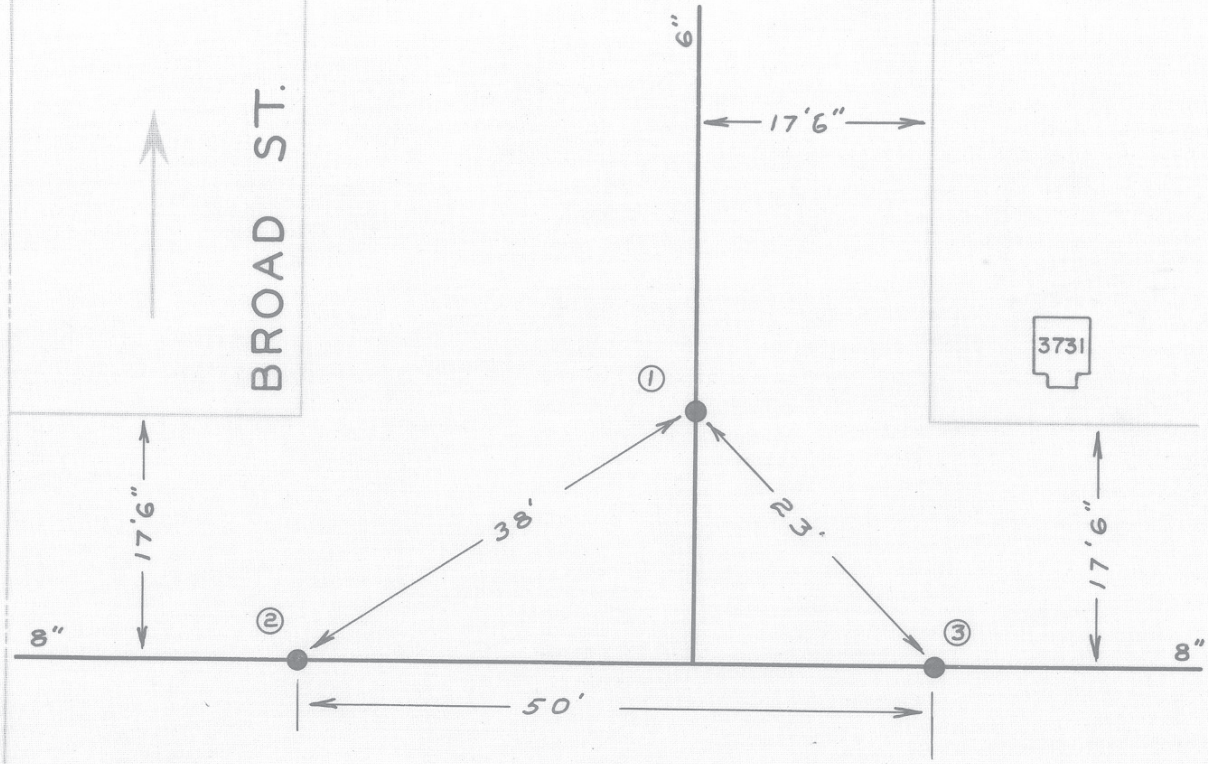

DATE	NO.	SIZE	MAKE	OPEN	TURNS
'56	1	6"	MUELLER	R	
'56	2	8"	DARLING	R	
'56	3	8"	DARLING	R	
	1	0	NPL		
	2	0	WPL		
	3	0	EPL		

GREENLAND

AVE. N. W.

2/87 NP

CITY OF ROANOKE—WATER DEP'T

VALVE DIAGRAM

BROAD ST. &

GREENLAND AVE. N.W.

SEC. MAP 215, 225

DATE PAGE NO.