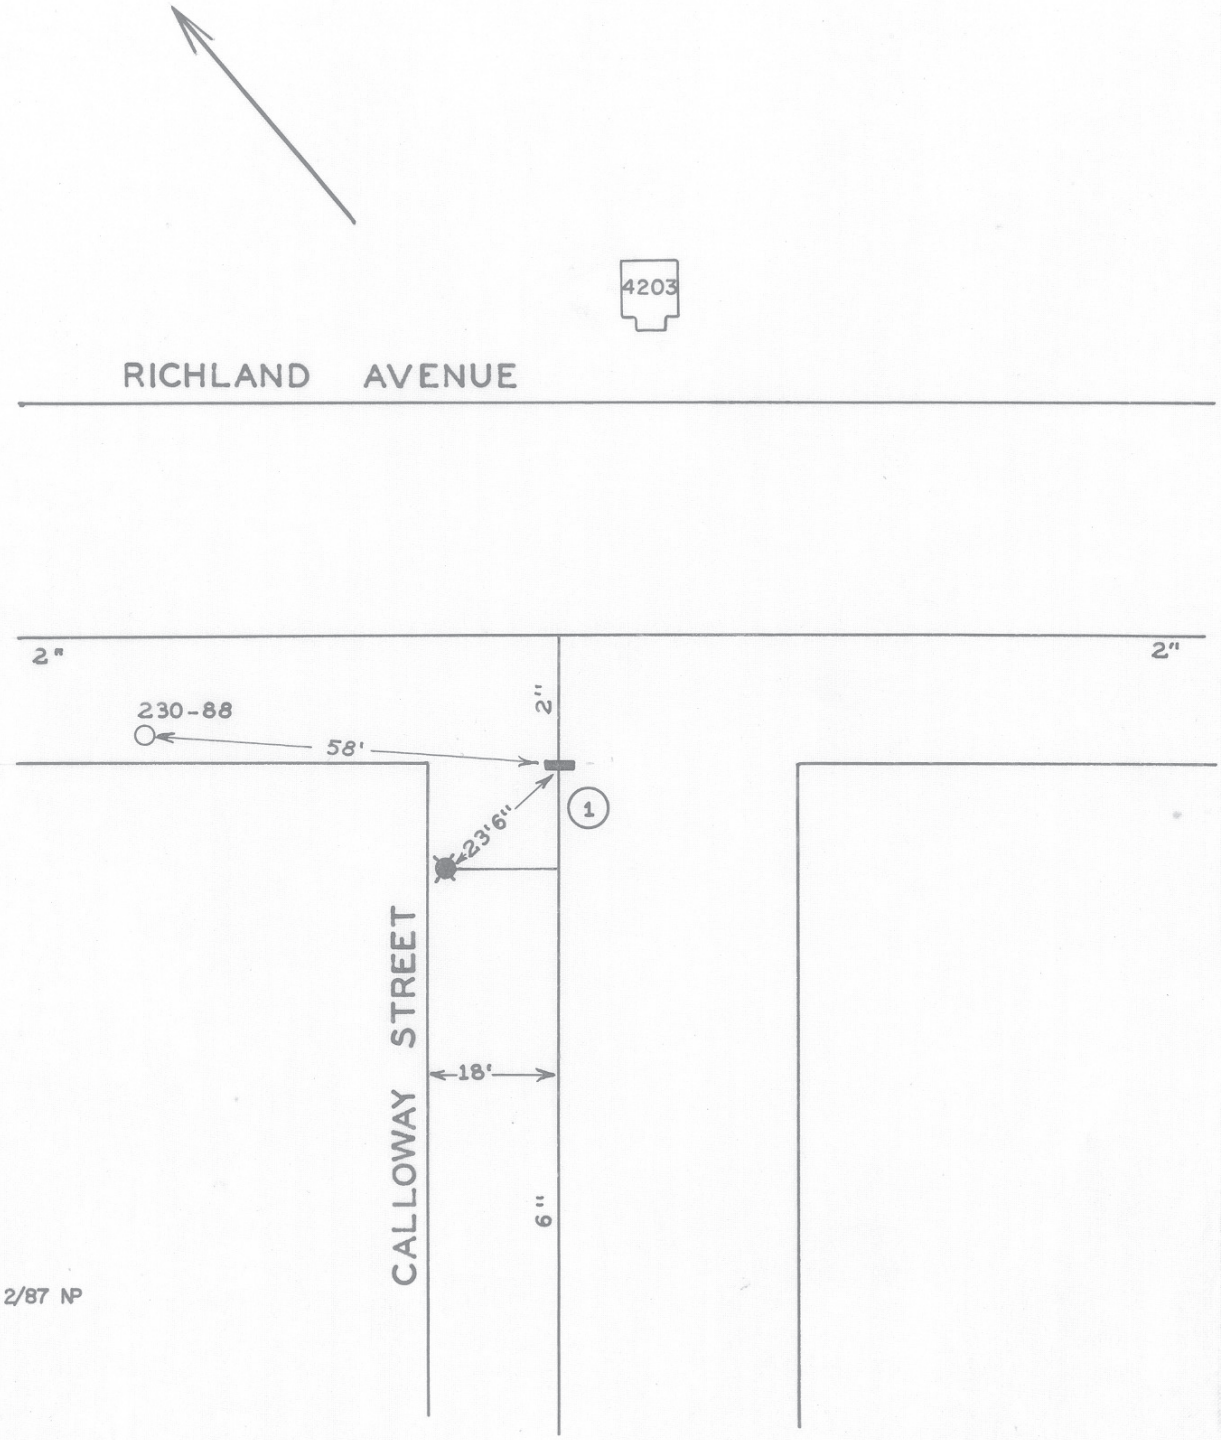

DATE	NO.	SIZE	MAKE	OPEN	TURNS
9-60	1	2"	DARLING	R	
	1	0	S.P.L.		

CITY OF ROANOKE — WATER DEPT.

VALVE DIAGRAM

CALLOWAY STREET &

RICHLAND AVENUE N.W.

SEC. MAP 216 N.W.

DATE PAGE NO.

2/87 NP

"IMPERIAL" TRACING CLOTH
K & E CO., N.Y.