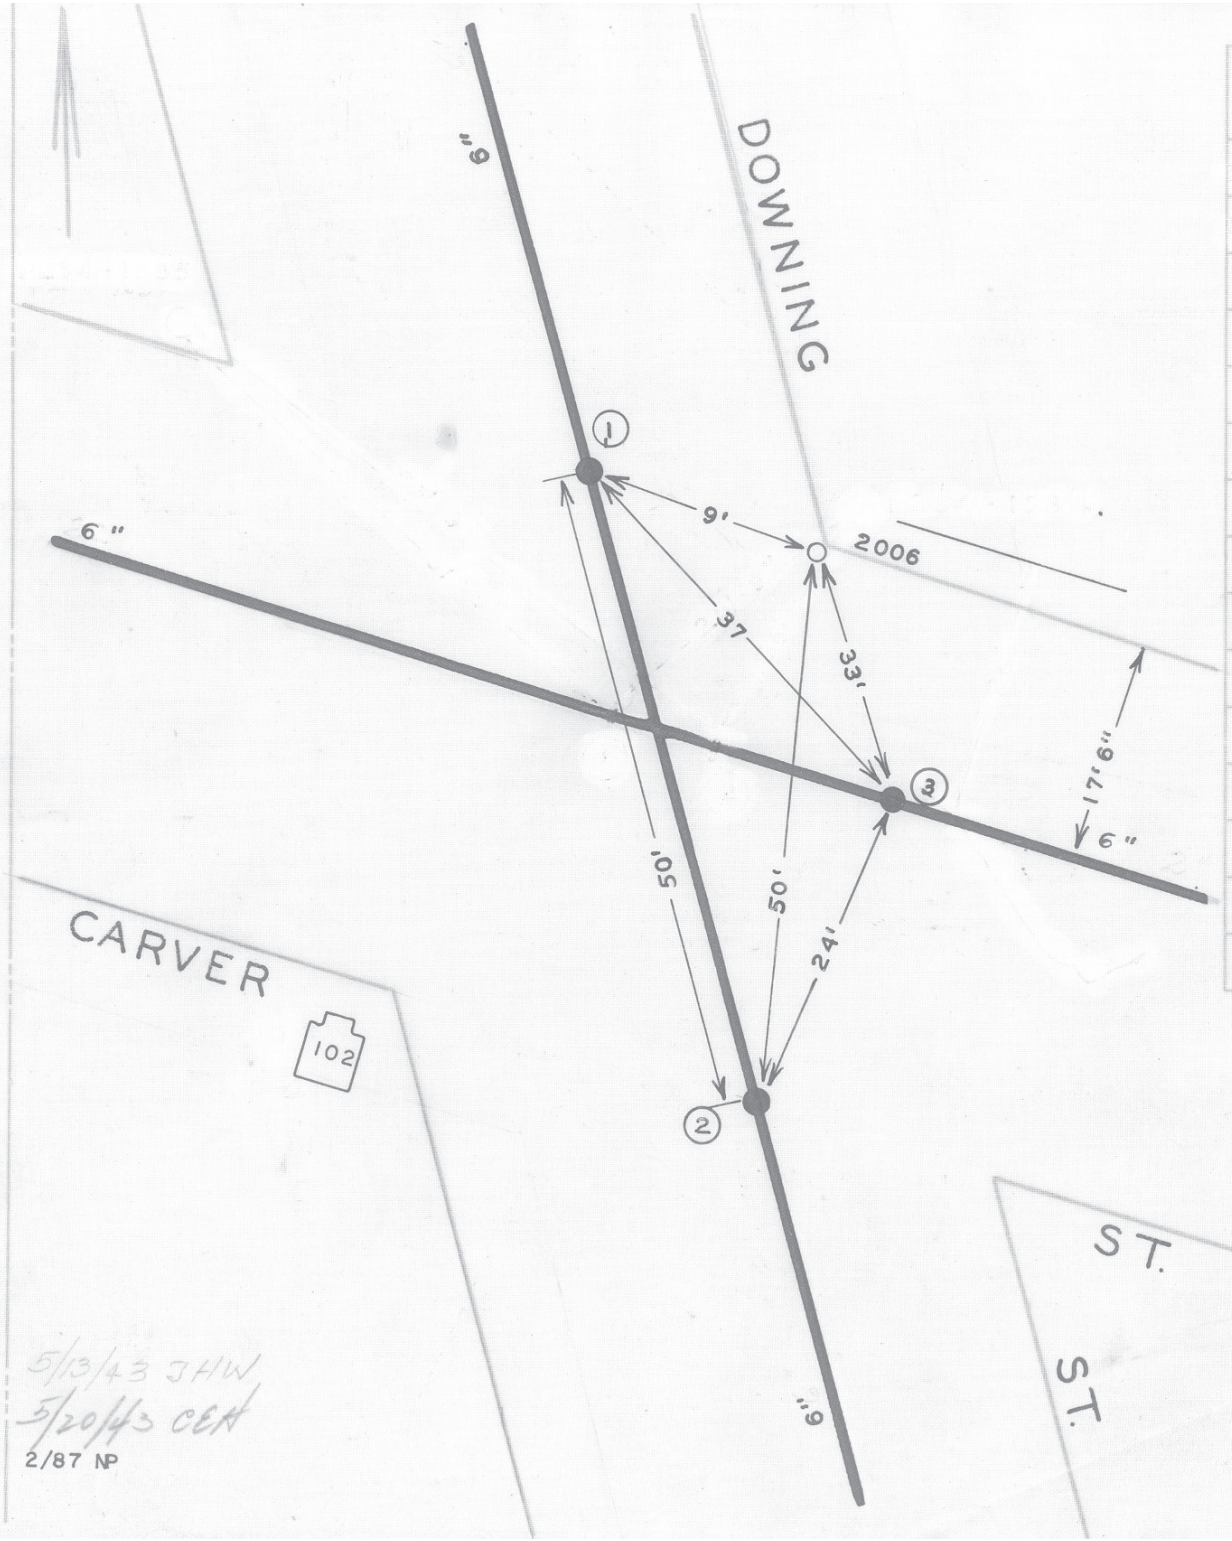

DATE	NO.	SIZE	MAKE	OPEN	TURNS
1-65	1	6"	MUELLER	R	
1-65	2	6"	MUELLER	R	
1-65	3	6"	MUELLER	R	
	1	0	N.P.L		
	2	0	S.P.L.		
	3	0	E.P.L.		

CITY OF ROANOKE—WATER DEP'T

VALVE DIAGRAM

CARVER STREET &

DOWNING STREET N.W.

SEC. MAP 204

DATE

PAGE NO. NW. 51

5/13/43 JHW
5/20/43 CEH
2/87 NP