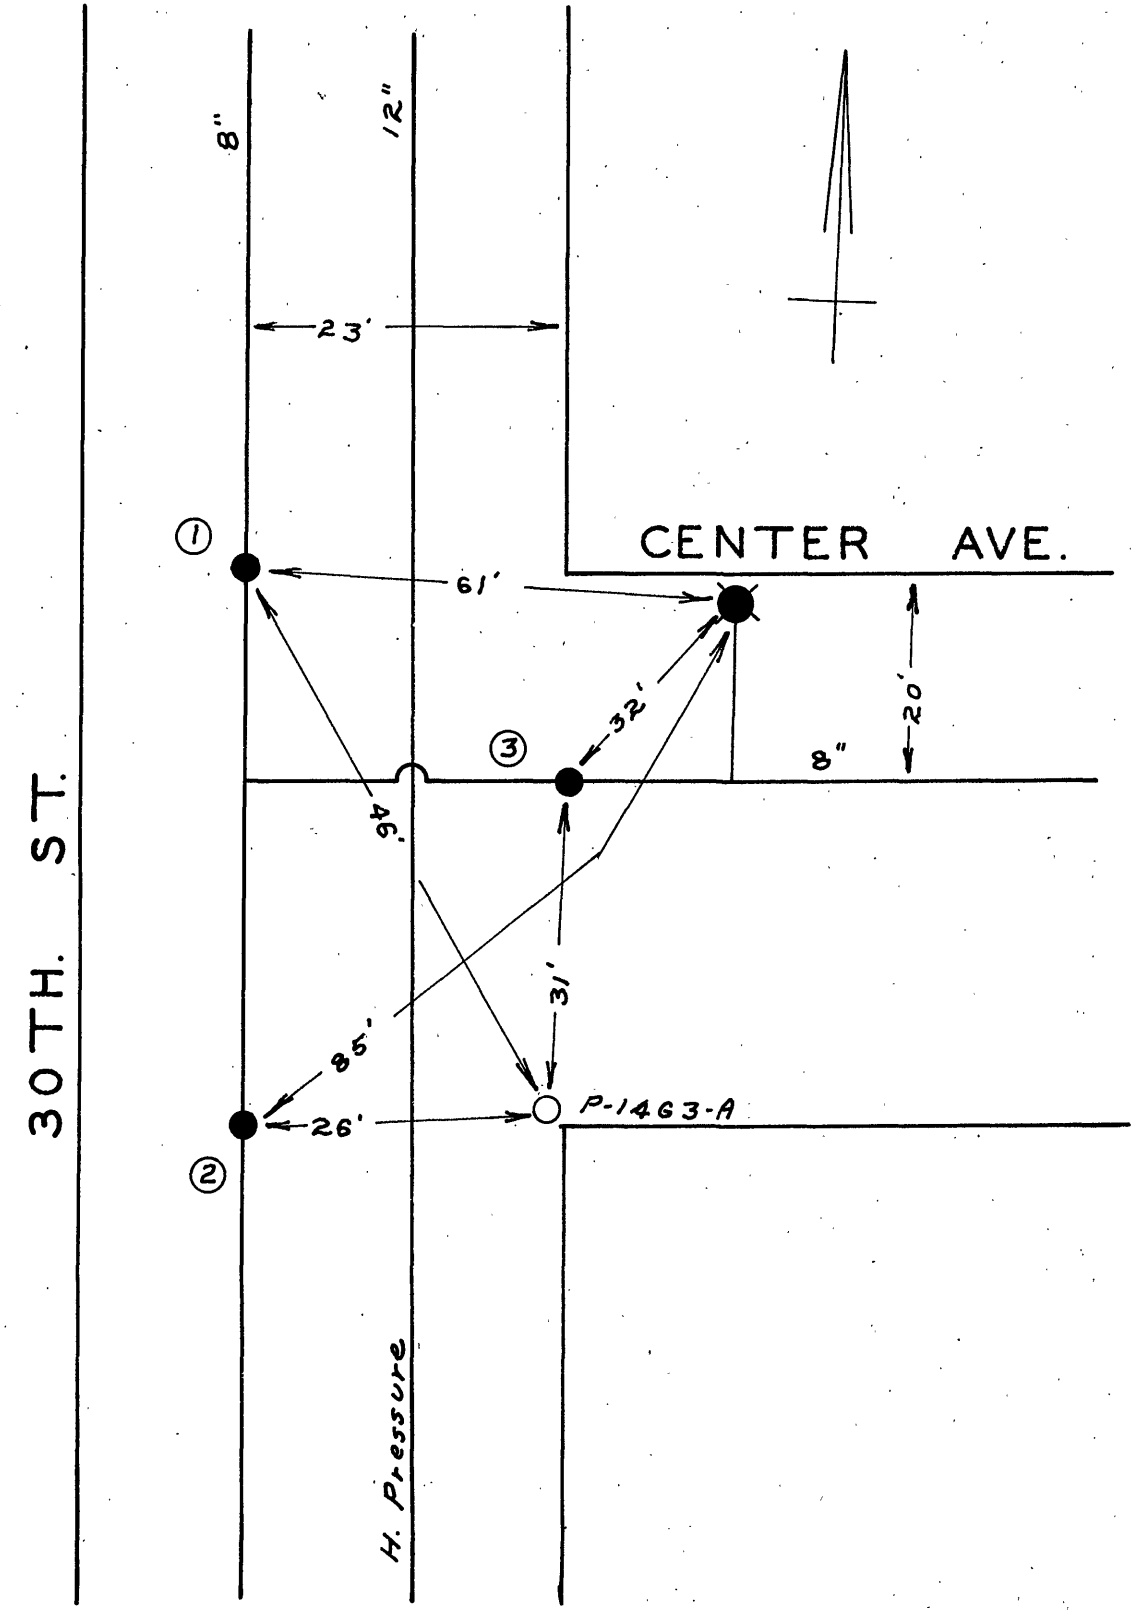

DATE	NO.	SIZE	MAKE	OPEN	TURNS
1952	1	8"	MUELLER	R	27
1952	2	8"	MUELLER	R	27
1952	3	8"	MUELLER	R	27
	1	0	NPL		
	2	0	SPL		
	3	0	EPL		

CITY OF ROANOKE — WATER DEPT.

VALVE DIAGRAM

CENTER AVE. & 30TH. STREET N.W.

SEC. MAP 242

DATE PAGE NO.

"IMPERIAL" TRACING CLOTH. K & E CO., N. Y.

5/88 NP