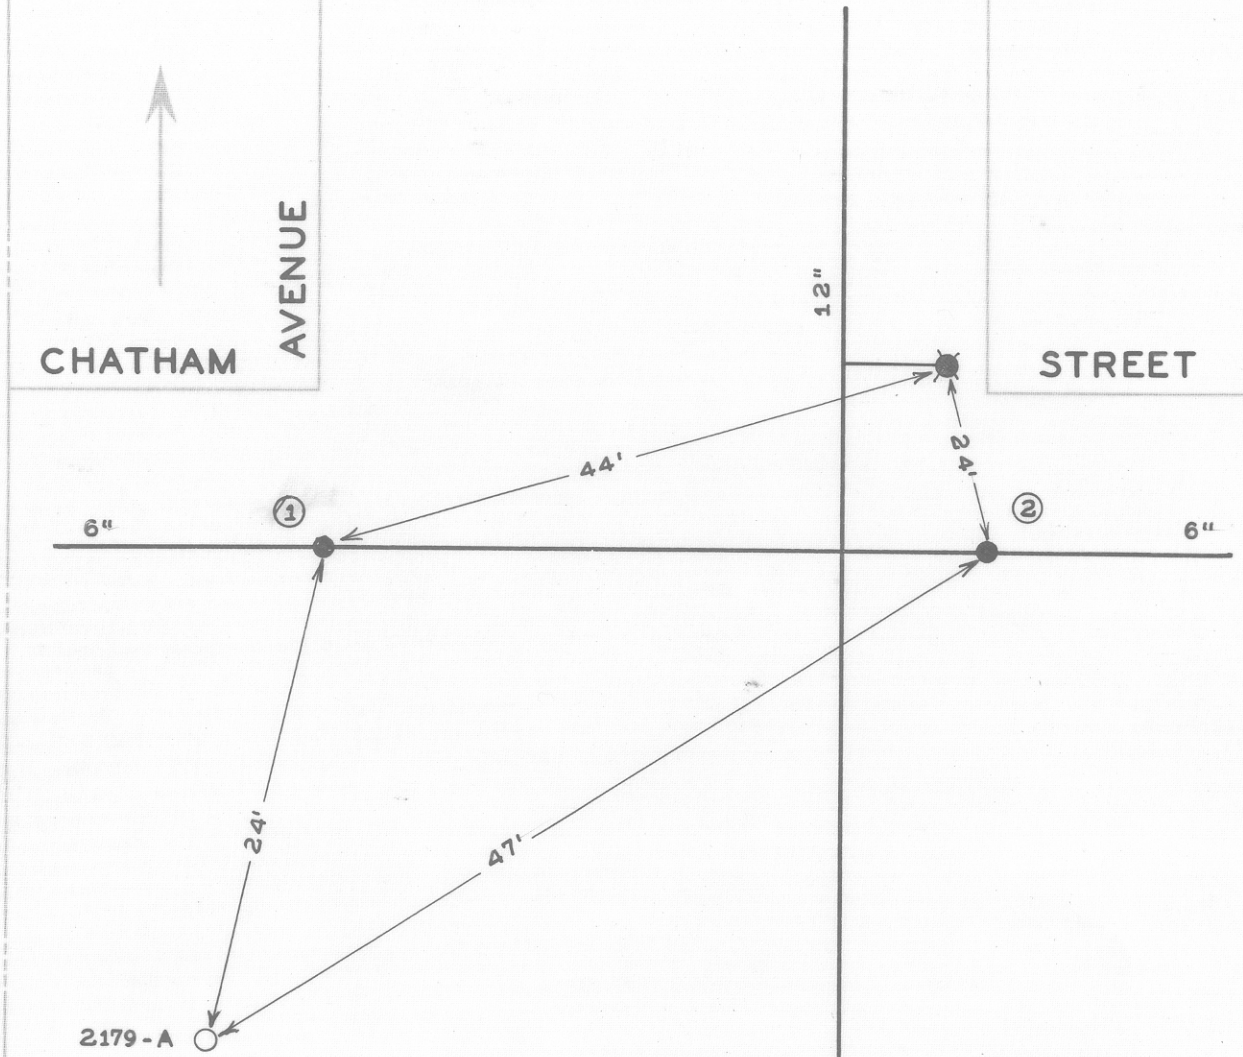

DATE	NO.	SIZE	MAKE	OPEN	TURNS
'60	1	6"	MUELLER	R	
'60	2	6"	MUELLER	R	
	1	0'	W.P.L.		
	2	0'	E.P.L.		

5/88 NP

CITY OF ROANOKE—WATER DEP'T

VALVE DIAGRAM

CHATHAM STREET &

HILLCREST AVENUE

N.W.

SEC. MAP 207

DATE PAGE NO.