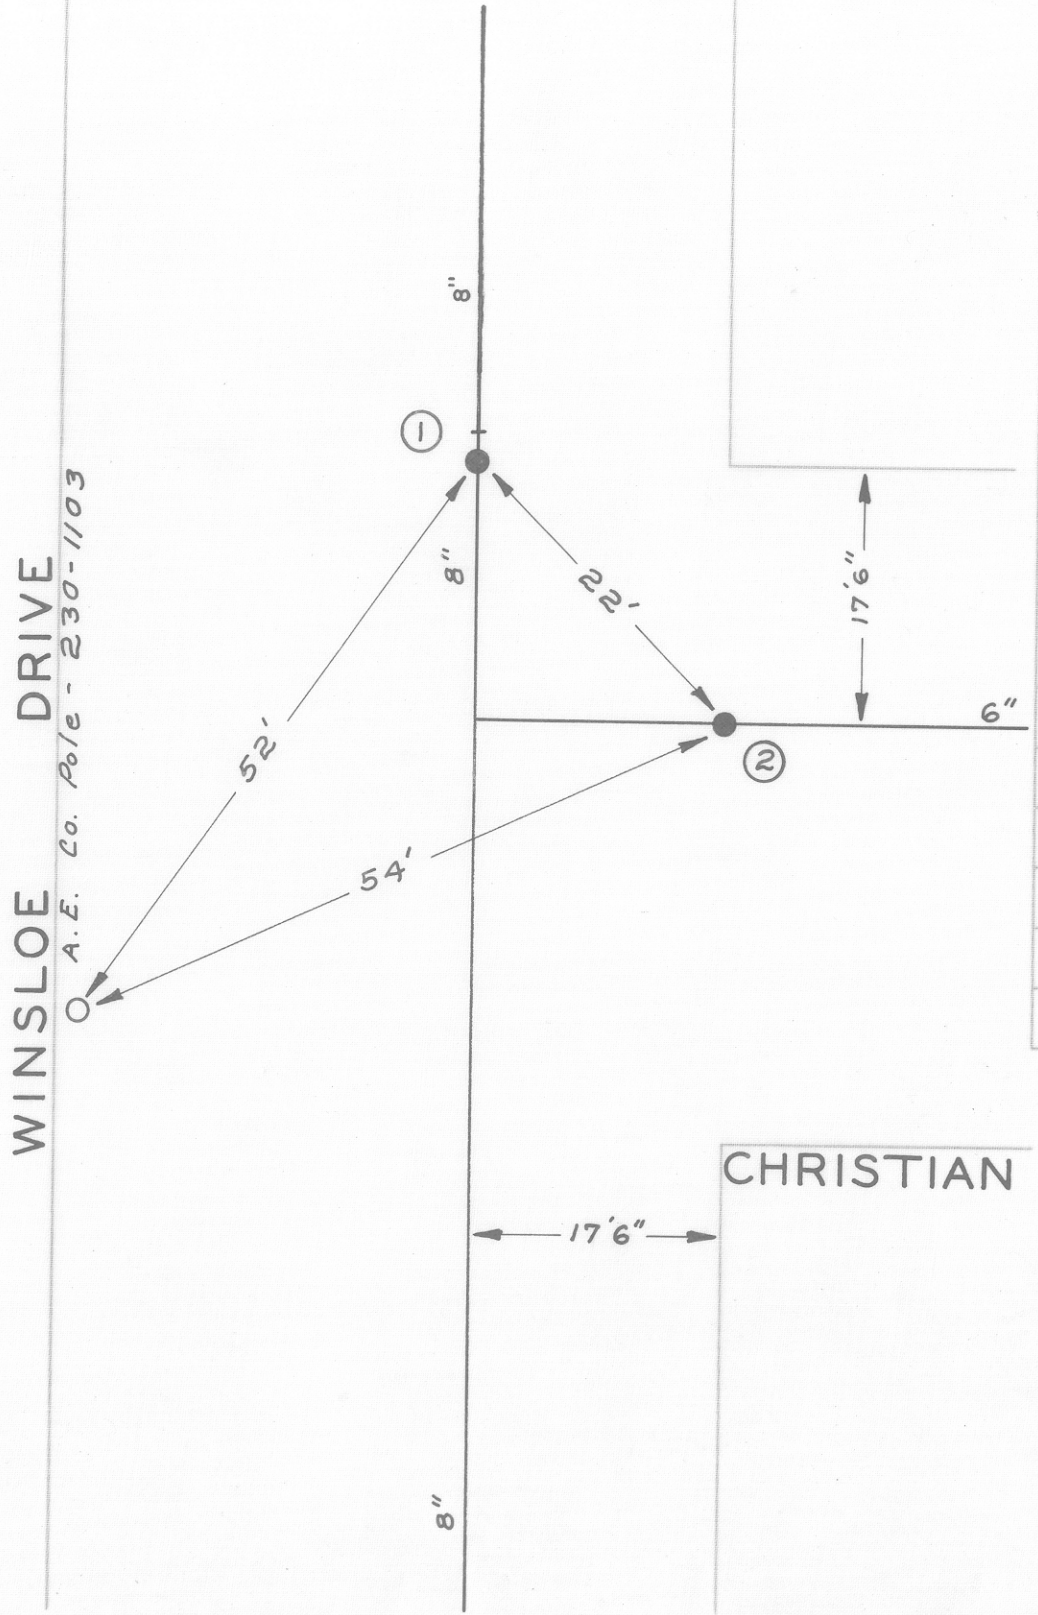

DATE	NO.	SIZE	MAKE	OPEN	TURNS
1958	1	8"	DARLING	R	
1958	2	6"	MUELLER	R	
	1	0	NPL		
	2	0	EPL		

CITY OF ROANOKE—WATER DEP'T

VALVE DIAGRAM

CHRISTIAN AVE. &

WINSLOE DRIVE N.W.

SEC. MAP 210

DATE PAGE NO.

5/88