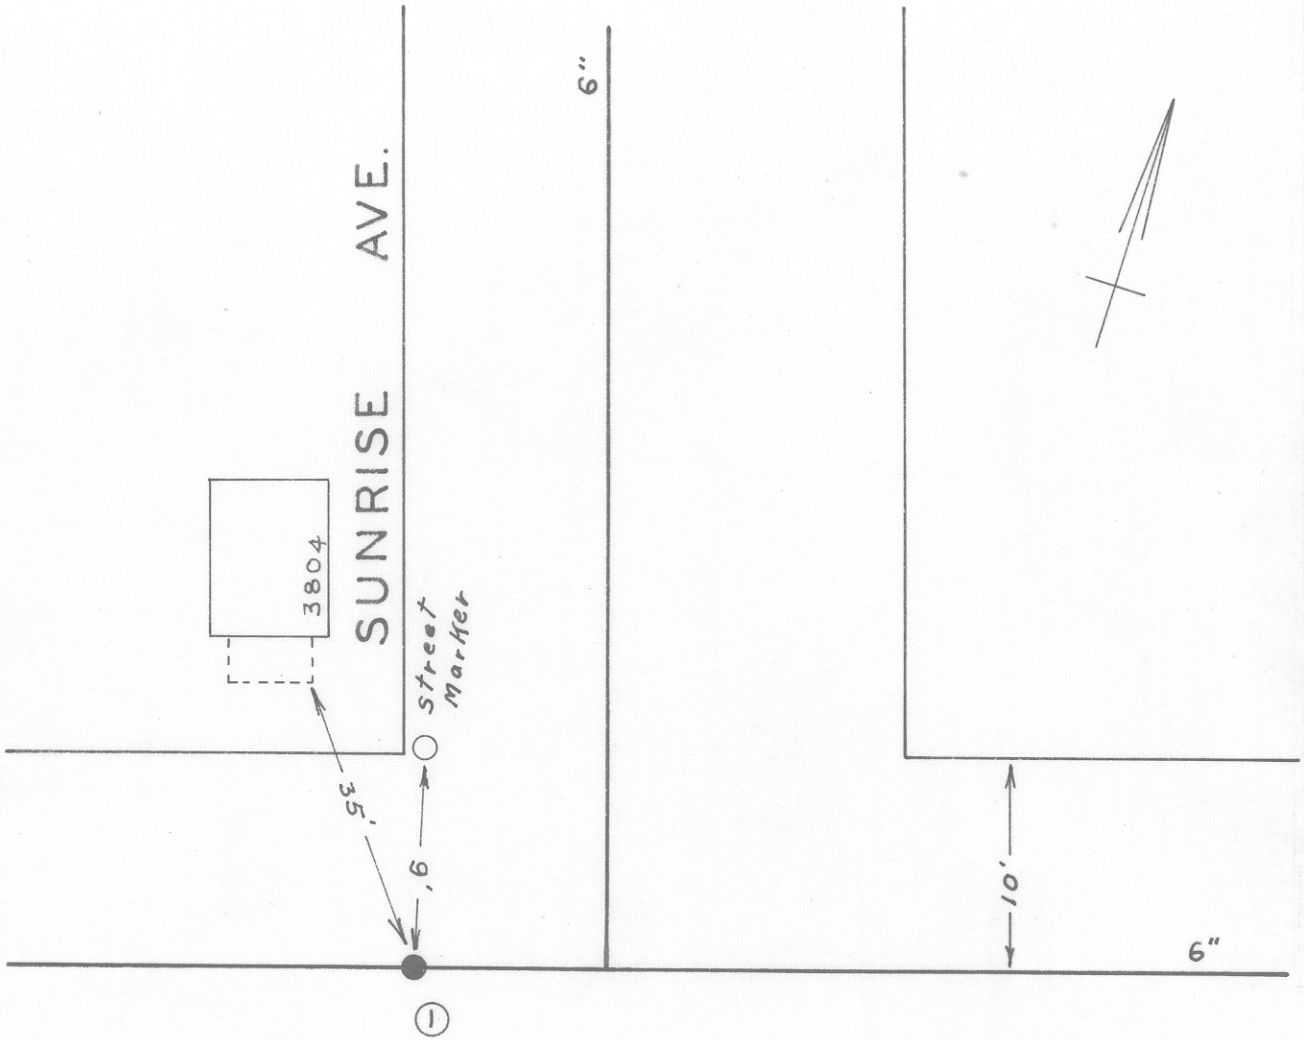


| DATE | NO. | SIZE | MAKE | OPEN | TURNS |
|---|---|---|---|---|---|
| 1953 | 1 | 6" | MUELLER | R | 20 |
| | | | | | |
| | | | | | |
| | 1 | 0 | WPL | | |
| | | | | | |
| | | | | | |

CITY OF ROANOKE — WATER DEPT.

VALVE DIAGRAM

CLARENDON ST. &

SUNRISE AVE. N. W.

SEC. MAP 216

DATE PAGE NO.

5/88 NP

"IMPERIAL" TRACING CLOTH
K & E CO., N. Y.