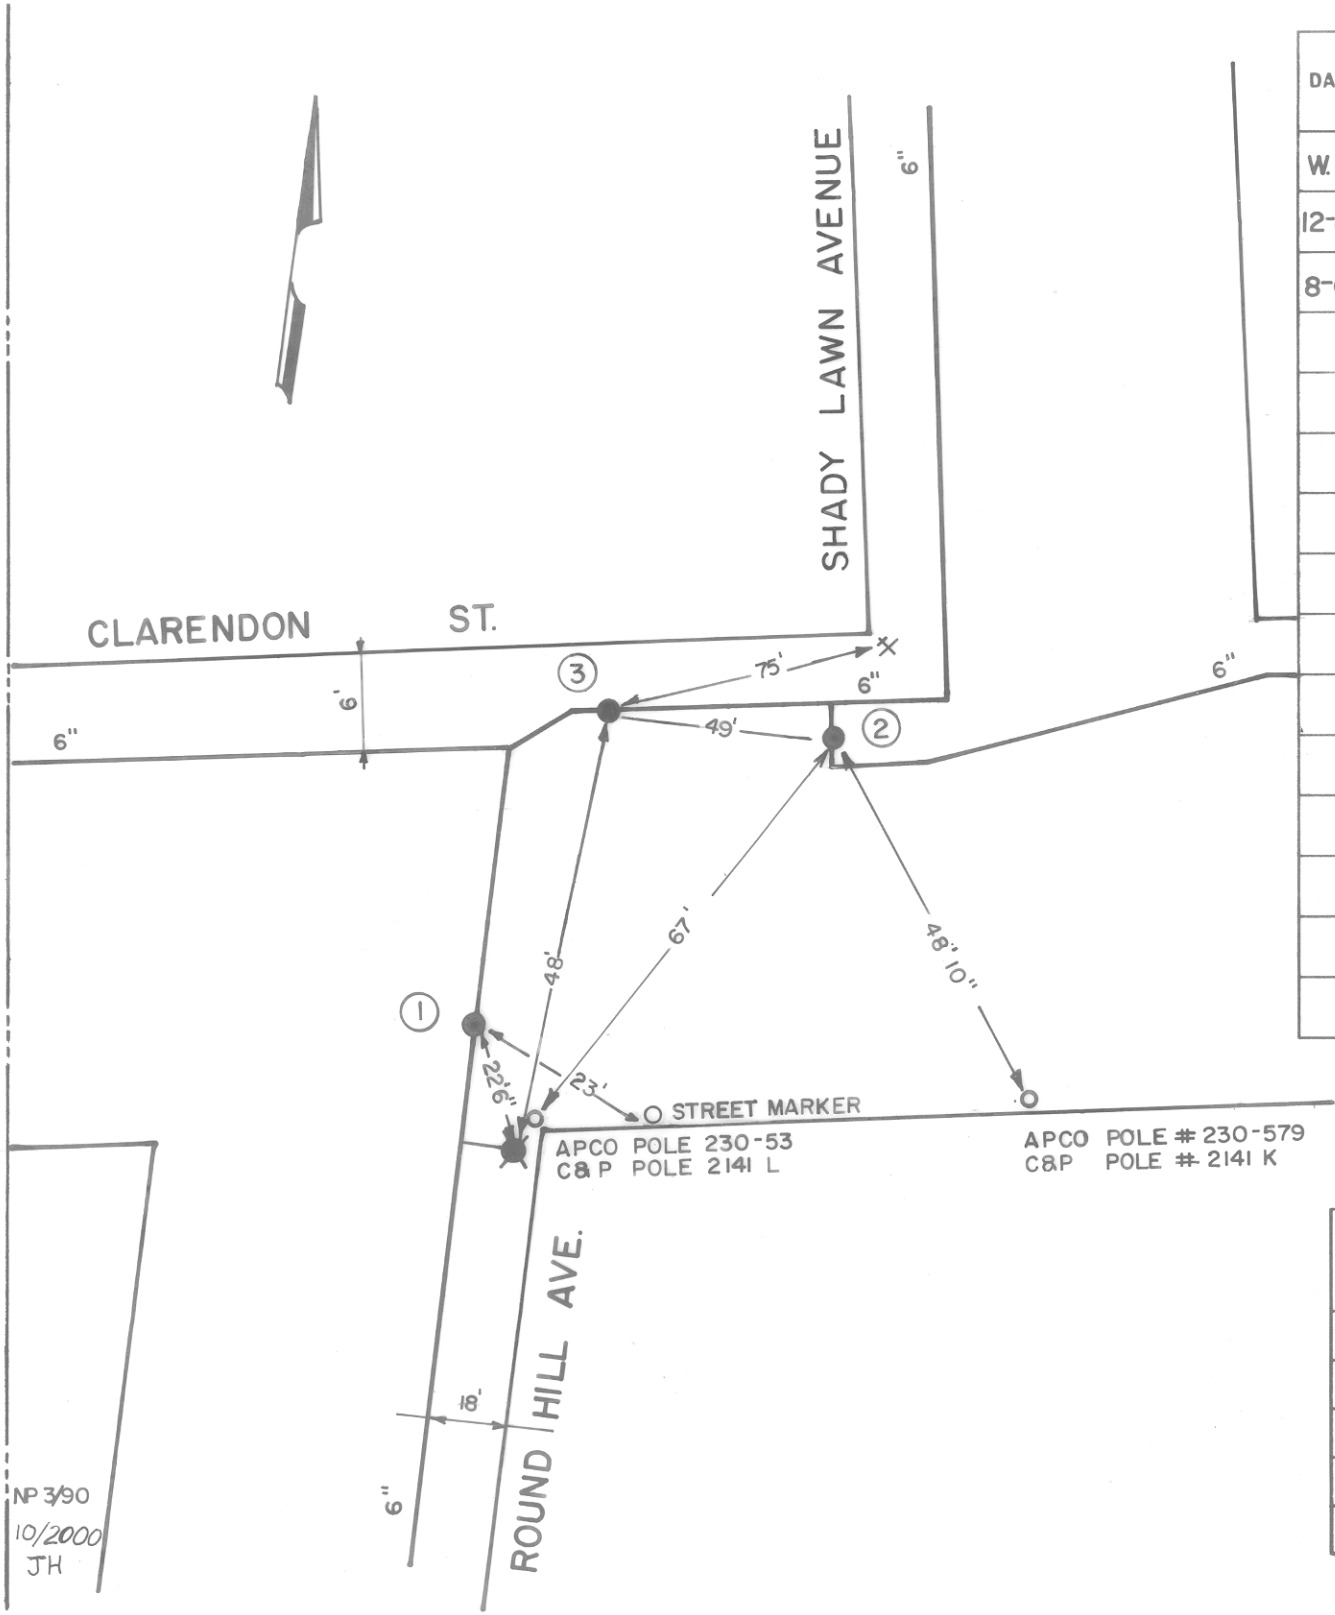

DATE	NO.	SIZE	MAKE	OPEN	TURNS
W.R.	1	6"		R	
12-84	2	6"		R	
8-62	3	6"	DARLING	R	
	1	15'N	SPL		
	3	0	EPL		

CITY OF ROANOKE—WATER DEP'T

VALVE DIAGRAM

CLARENDON ST.

ROUND HILL AVE.

SHADY LAWN AVENUE

SEC. MAP 208, 216 N.W.

DATE PAGE NO.